


T.14S.R.10E.W.M.

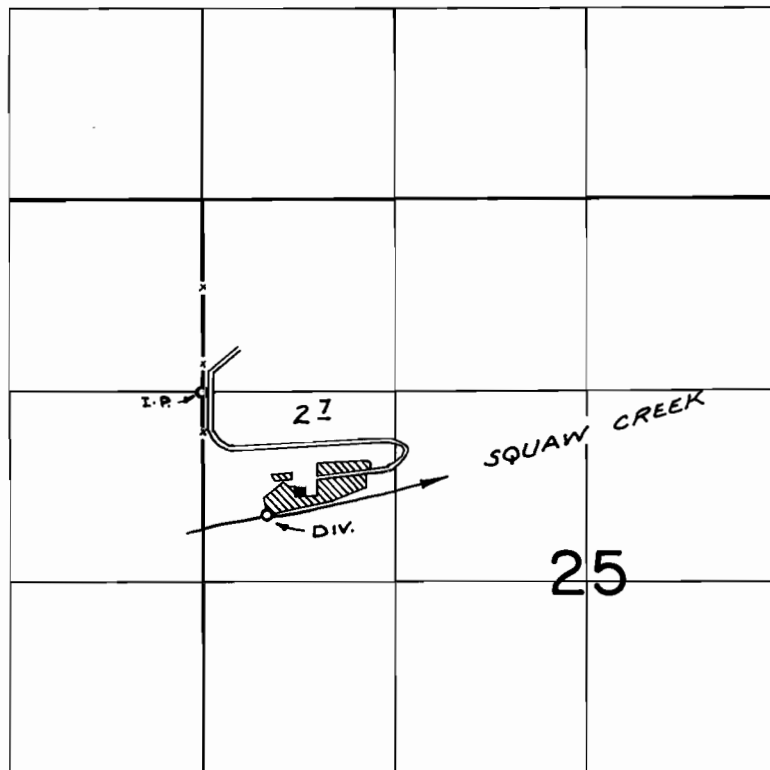

DIV. LOC: 850'S. & 430 E. FROM N.W. COR. SW 1/4 NW 1/4 SEC. 25

FINAL PROOF SURVEY
UNDER

Application No. 49723 Permit No. 37230
IN NAME OF

ALFRED B. RAMSEY

Surveyed AUG. 31, 1976. by R. MUCKEN