


T.30S.R.4W.W.M.

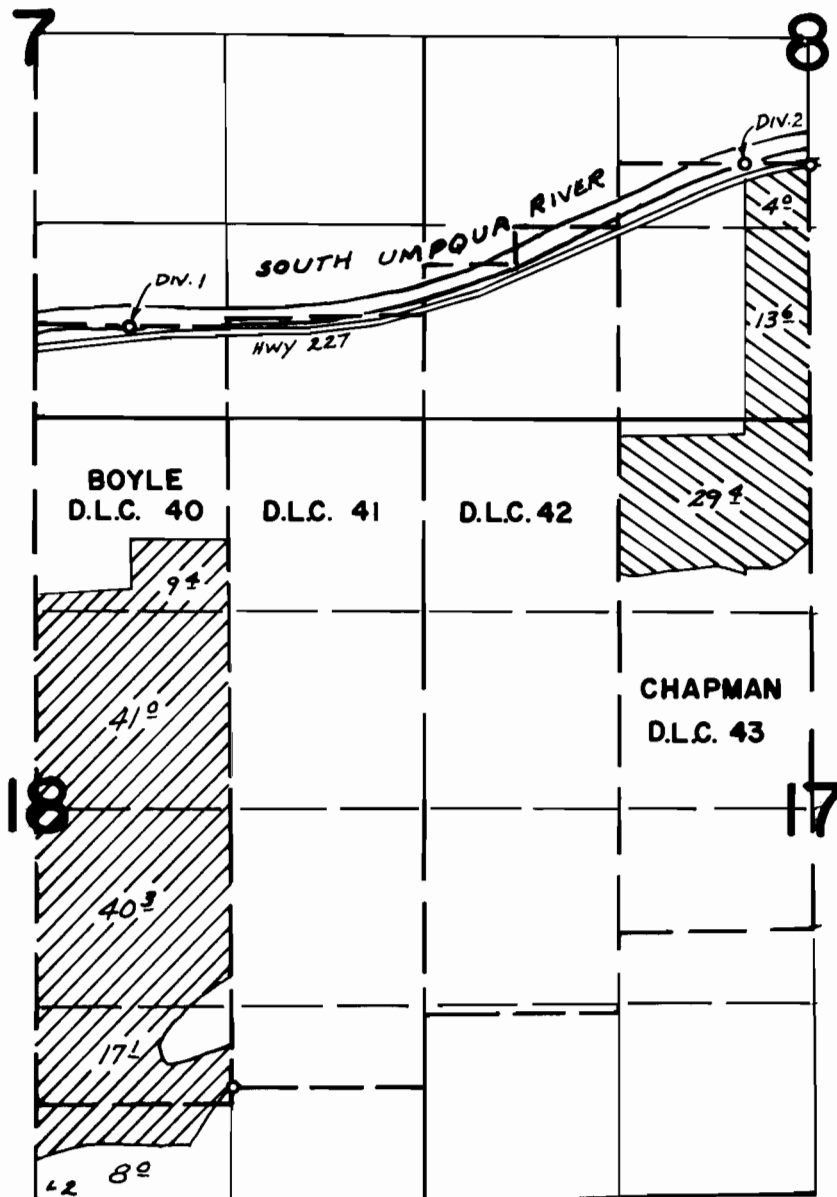

DIV. PTS. LOC: #1 - 620' N. & 2000' W; #2 - 1750' N. & 2200' E,
BOTH FROM S.E. COR. SEC. 7

FINAL PROOF SURVEY UNDER

Application No. ⁴⁵⁶⁷³ 45714 Permit No. ³⁴⁰⁷⁷ 34098
IN NAME OF

GREEN VALLEY FARMS

Surveyed *MAY 12* 1976, by *L.E. GOULD*