


T.2N.R.20E.W.M.

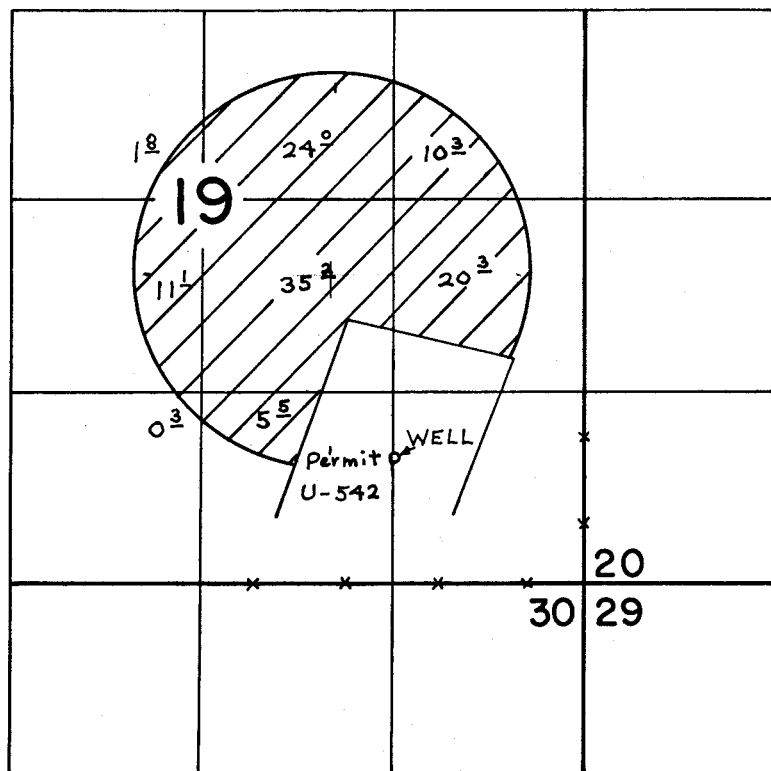

WELL LOC. - 850' N. & 1300' W. FROM S.E. COR. SEC. 19

FINAL PROOF SURVEY
UNDERApplication No. G-5804 Permit No. G-5026
IN NAME OFBIG SKY RANCH INC.Surveyed July 14 1976, by R.G. Mucken.