


G-5566
4664

T.2N.R.20E.W.M.

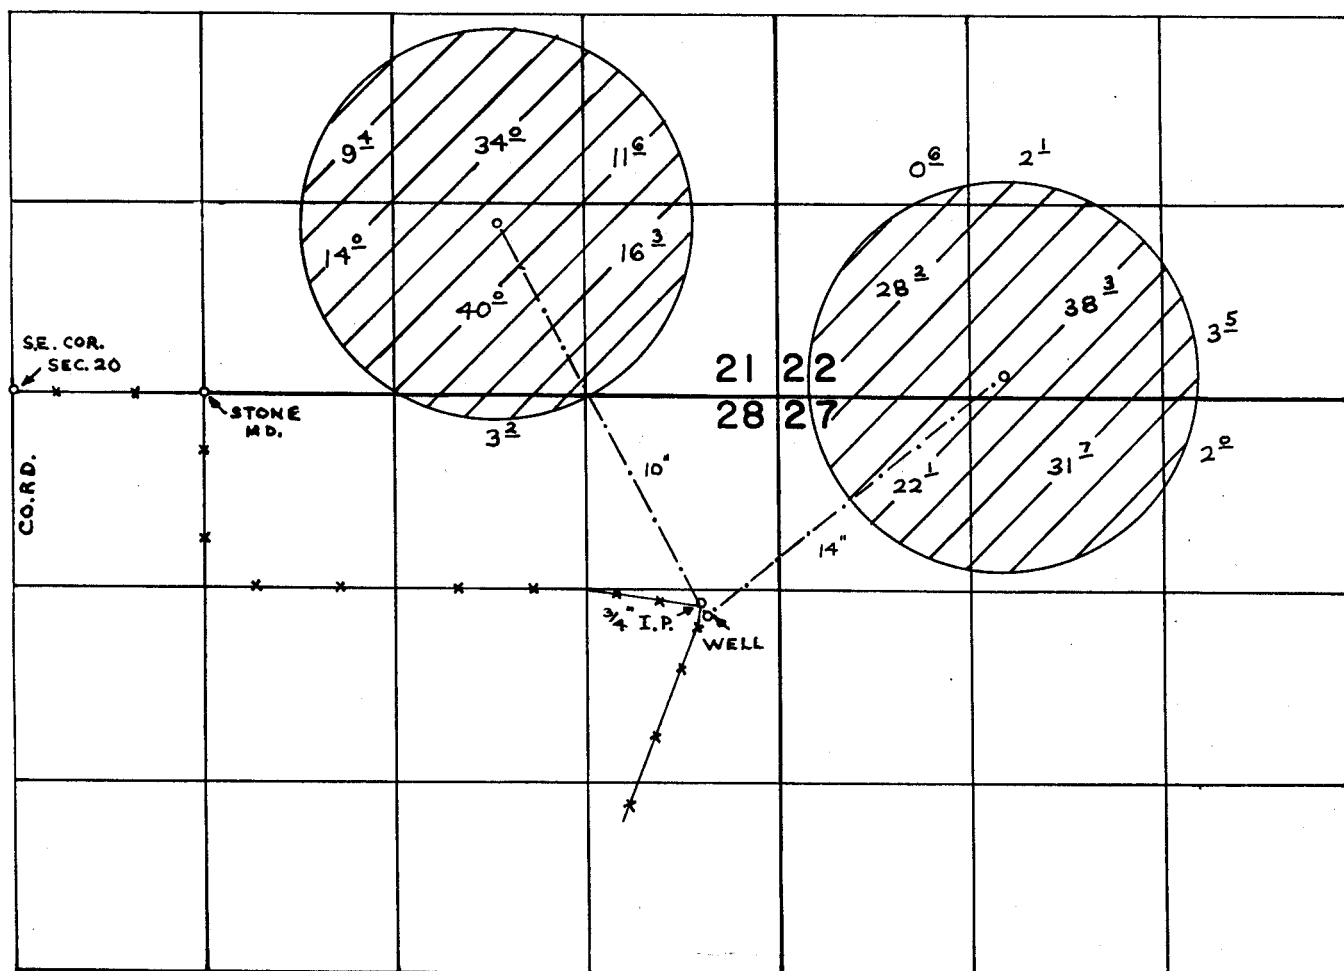

WELL LOC. - 1500' S. & 500' W. FROM N.E. COR. NE. 1/4 NE. 1/4 SEC. 28

FINAL PROOF SURVEY UNDER

Application No. G-5803 Permit No. G-5566
IN NAME OF

BIG SKY RANCH INC.

Surveyed July 14, 1976, by R.G. Mucken

DHM
1976 Z-1