


T.26S.R.31E.W.M.  
SOUTH OF MALHEUR LAKE

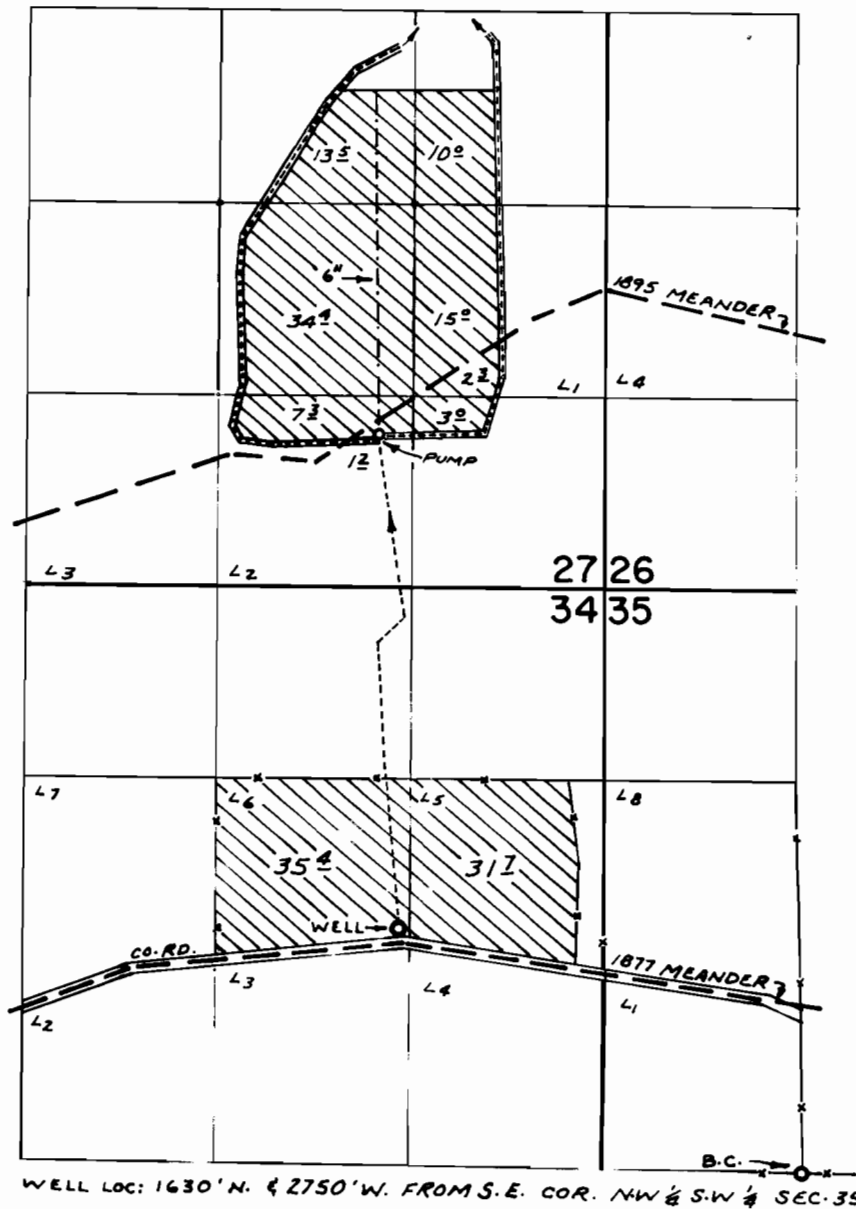

**FINAL PROOF SURVEY**  
UNDER

Application No. G-4650 Permit No. G-4374  
IN NAME OF

WALTER T. McEwen

Surveyed JUNE 24, 1976, by R. MUCKEN