


T.37S.,R.IW.,W.M.

5 Ctr. 1/4 Cor. Sec. 6

LANE

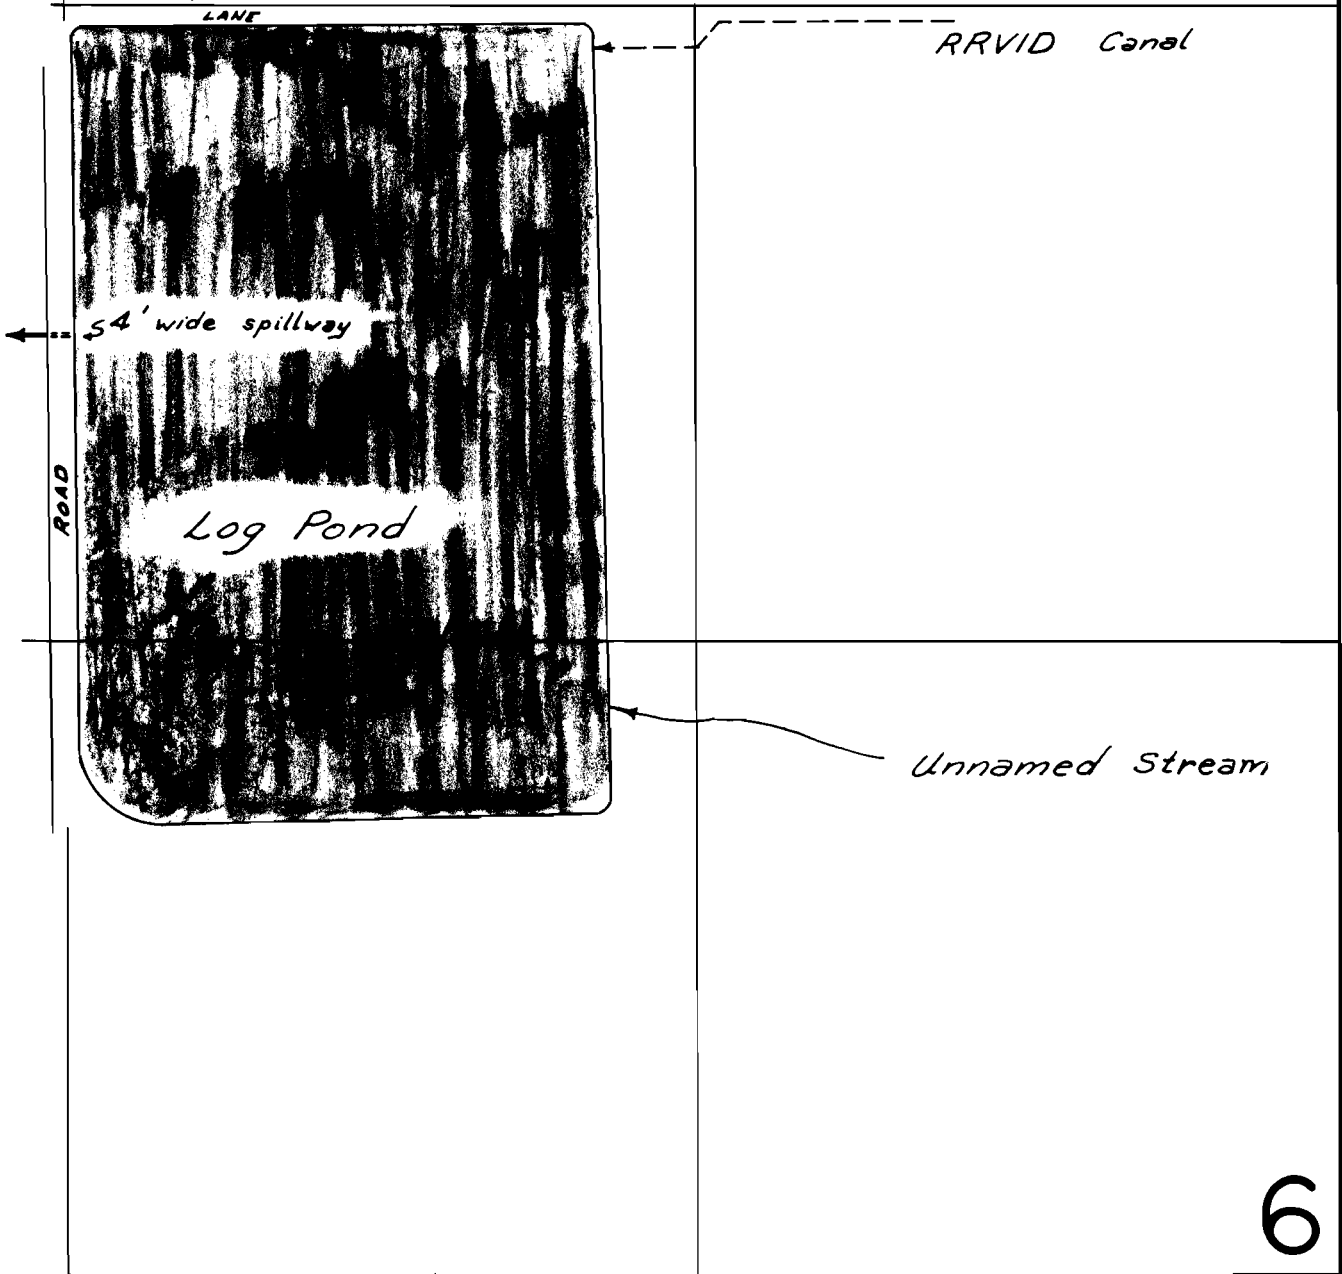

Scale 1" = 400'
FINAL PROOF SURVEY
UNDER

Application No. 30741 Permit No. 24500
R-30742 R-1937
IN NAME OF

Medford Corporation

Surveyed Feb. 28, 1974, by David C. Hendrix

JA-19-21 *ACB*