


T.36S.R.21E.W.M.

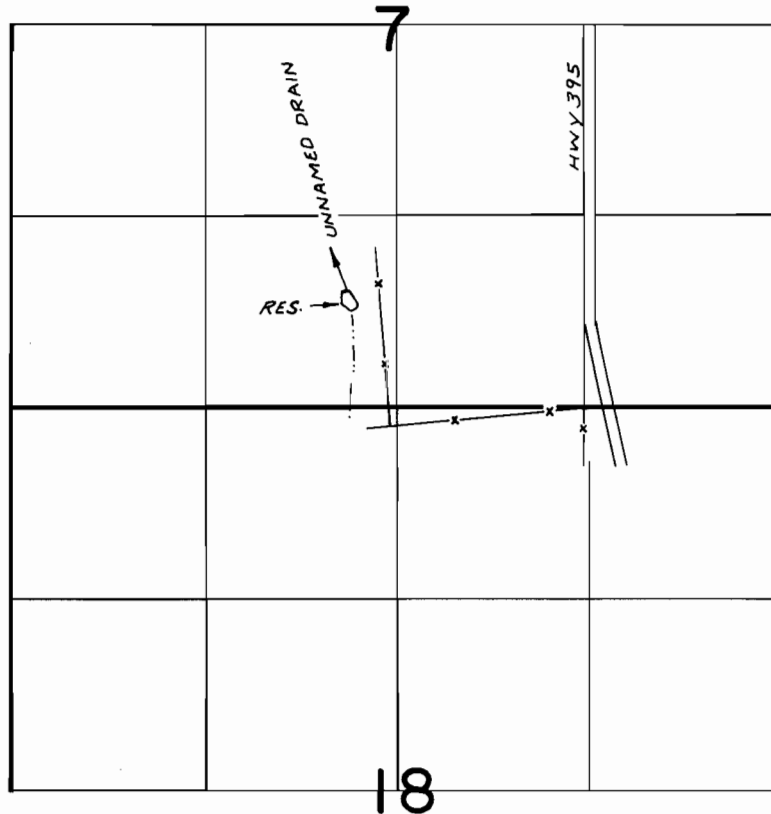

FINAL PROOF SURVEY
UNDER

Application No. R-52309 Permit No. R-6300
IN NAME OF

DOUGLAS M. ELDER

Surveyed OCT. 25, 1976, by R. MUCKEN