


T.17S., R.3W., W.M.

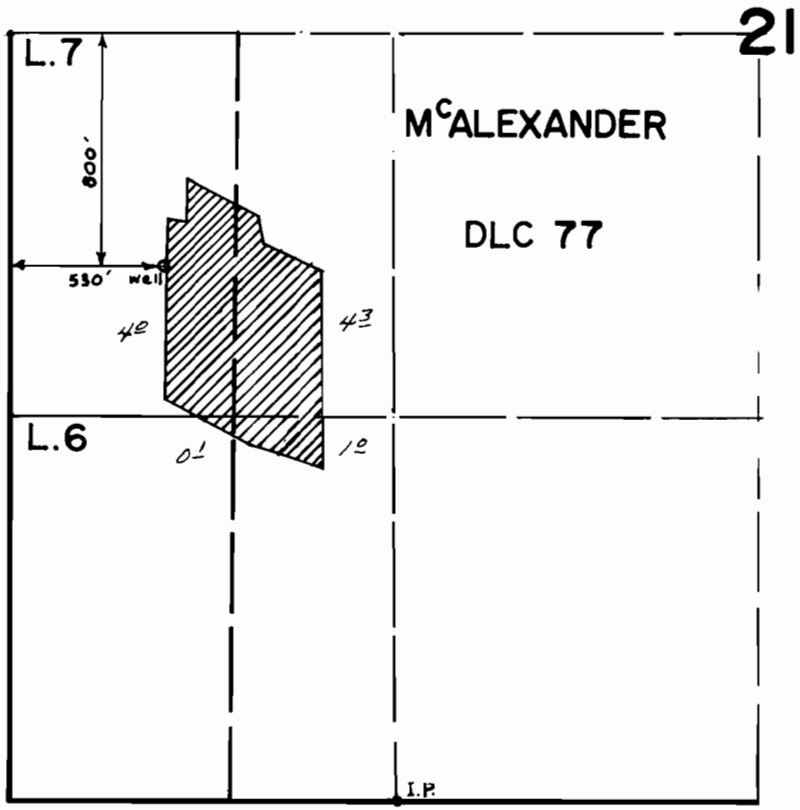

SCALE: 1" = 660'

FINAL PROOF SURVEY
UNDER

Application No. G-3577 Permit No. G-3370
IN NAME OF
CITY OF EUGENE
DEPARTMENT OF PARKS & RECREATION

Surveyed MAY 20 1976, by D. NORBY