


T. 15 S., R. 4 W., W.M.

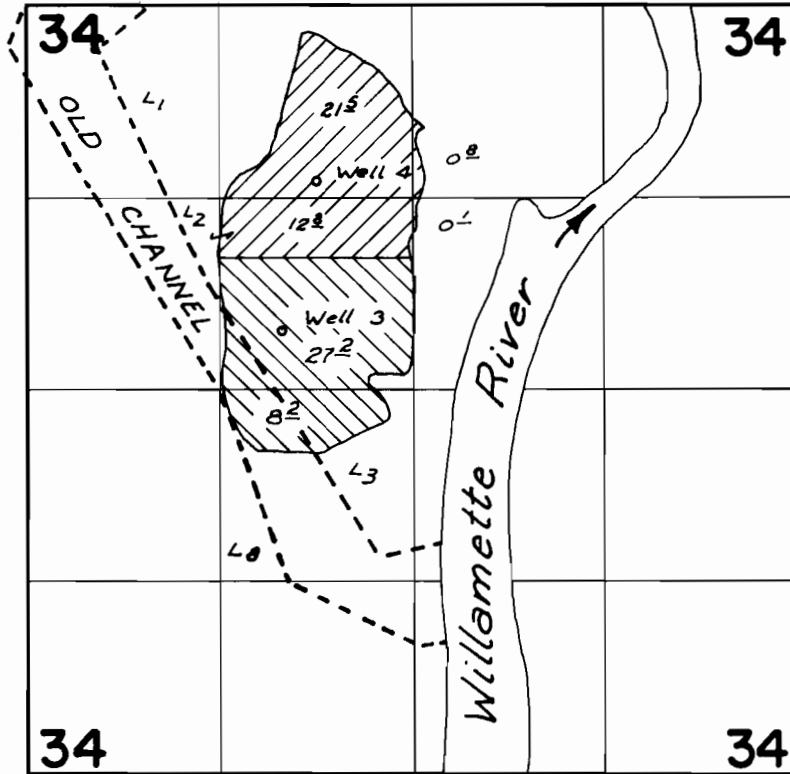

Wells Loc.: #3 - 2250' S. & 1750' E.; #4 - 1210' S. & 1980' E., from NW. Cor. Sec. 34

 Well 3
 Well 4

FINAL PROOF SURVEY UNDER

Application No. G-5457 Permit No. G-4960
IN NAME OF

Brochner & Arlene Mikkelsen

Surveyed May 10 1976, by D.M. Norby

DBQ-2JJ-5 