


T. 15.S., R. 4 W., W.M.

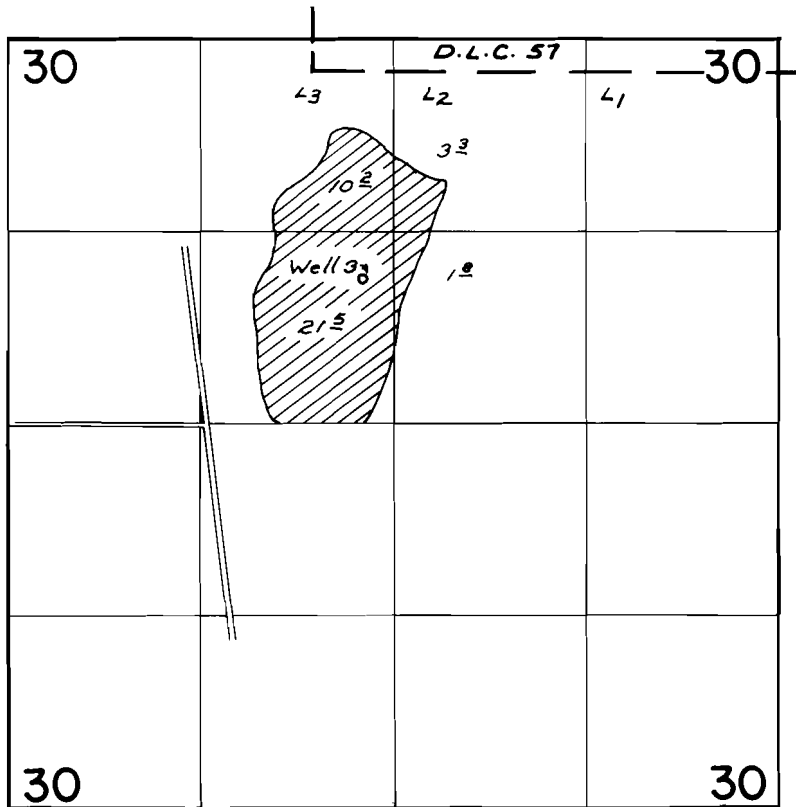

Well. Loc.: 3650' N of 2850' W from S.E. Cor.
Sec. 30

FINAL PROOF SURVEY UNDER

Application No. G-5708 Permit No. G-5516
IN NAME OF

Paeschke Farms, Inc.

Surveyed May 11 1976, by D.M. Norby