


T.17S. R.2W. W.M.

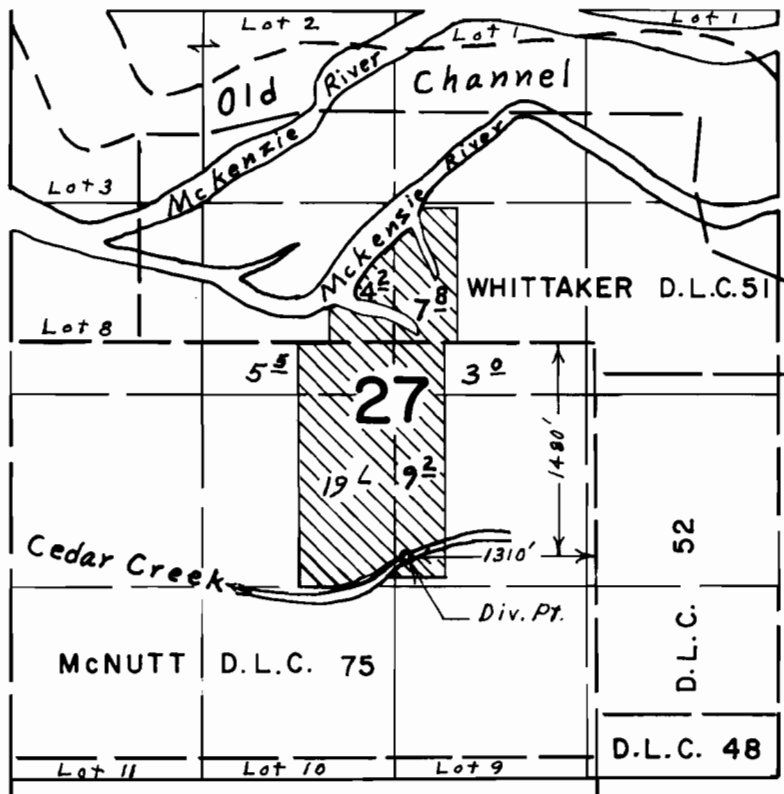

**FINAL PROOF SURVEY**  
UNDER

Application No. 49046 Permit No. 35935  
IN NAME OF

GEORGE W. & MELINDA W. GRIER

Surveyed June 22, 1975, by L. E. Gould.