


T.16 & 17S., R.2W., W.M.

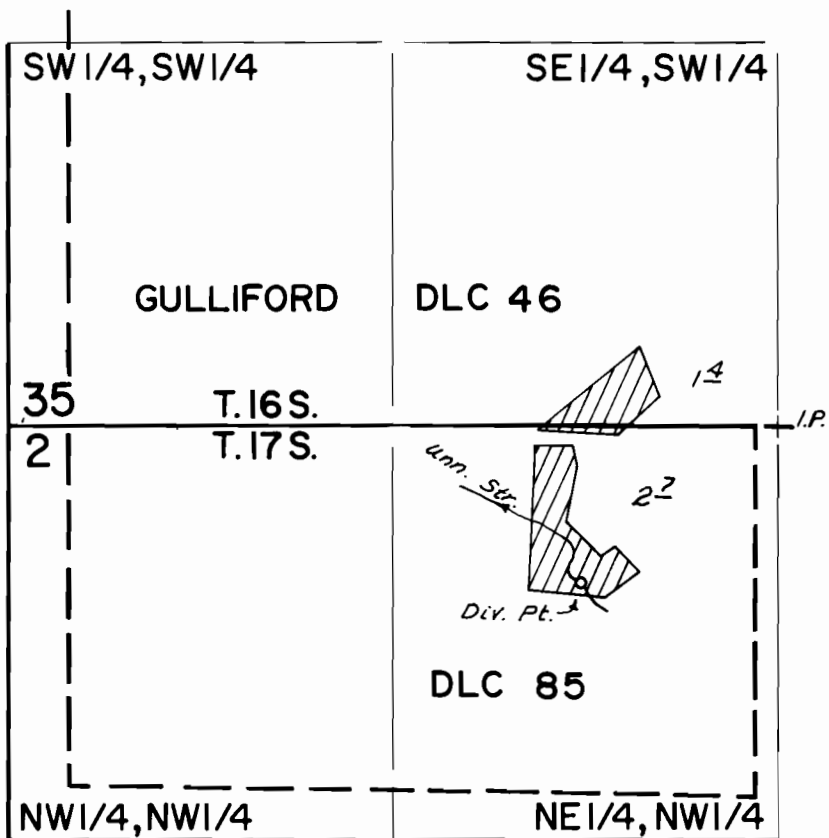

DIV. PT. LOC.: 540'S & 680'W from S 1/4 cor. Sec. 35

SCALE 1" = 660'

FINAL PROOF SURVEY

UNDER

Application No. 5/338 Permit No. 37437
IN NAME OF

Lloyd George Felkner

Surveyed Oct 28, 1976, by D. M. Norby

PTS-1976-C *ACB*