


T.11S., R.2W., W.M.

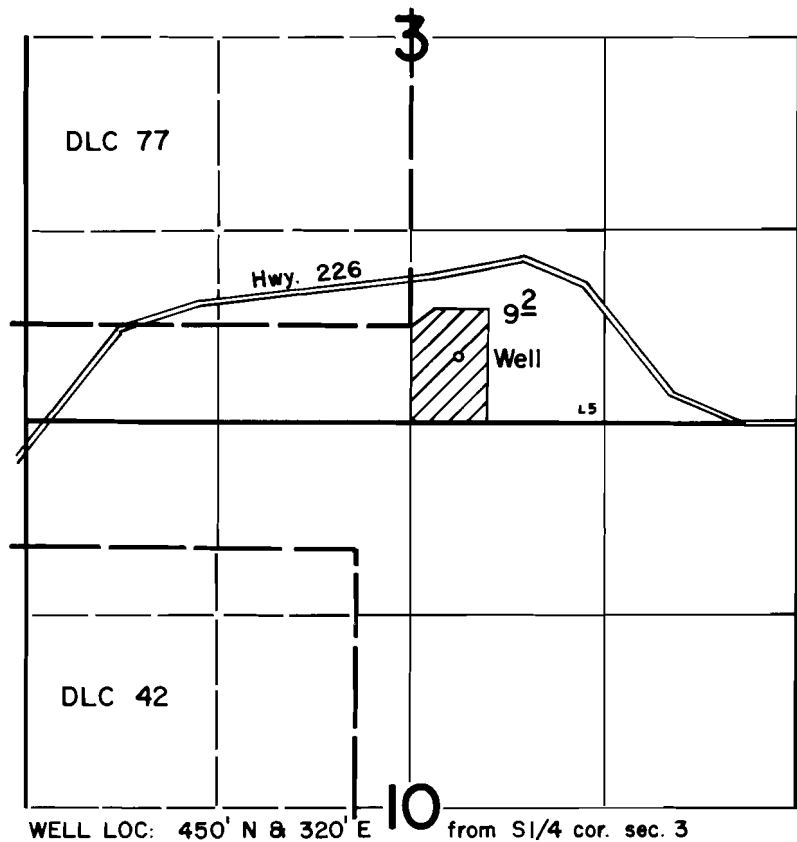

FINAL PROOF SURVEY
UNDER

Application No. G-5592 Permit No. G-5447
IN NAME OF

AMOS B. AND LOUIS V. GERIG

Surveyed April 14 1976, by D. Norby