


T.10S., R.4W., W.M.

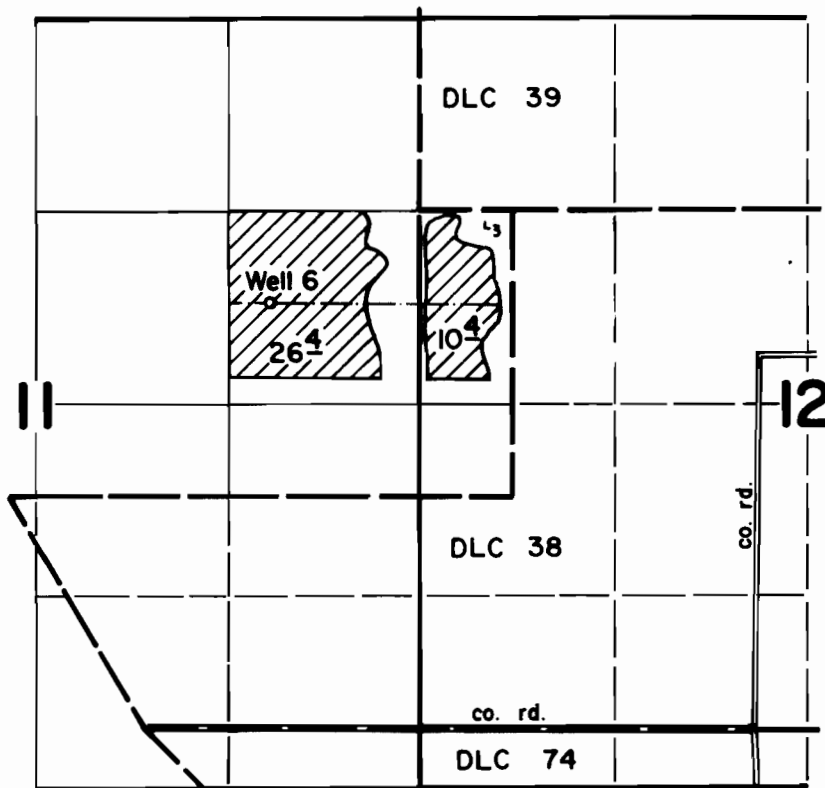

WELL LOC: 700' N & 1020' W from E 1/4 cor. sec. 11

FINAL PROOF SURVEY UNDER

Application No. G-5832 Permit No. G-5578
IN NAME OF

ADEN A. CHAMBERS

Surveyed April 15, 1976, by D. Norby