


T.10S., R.2W., W.M.

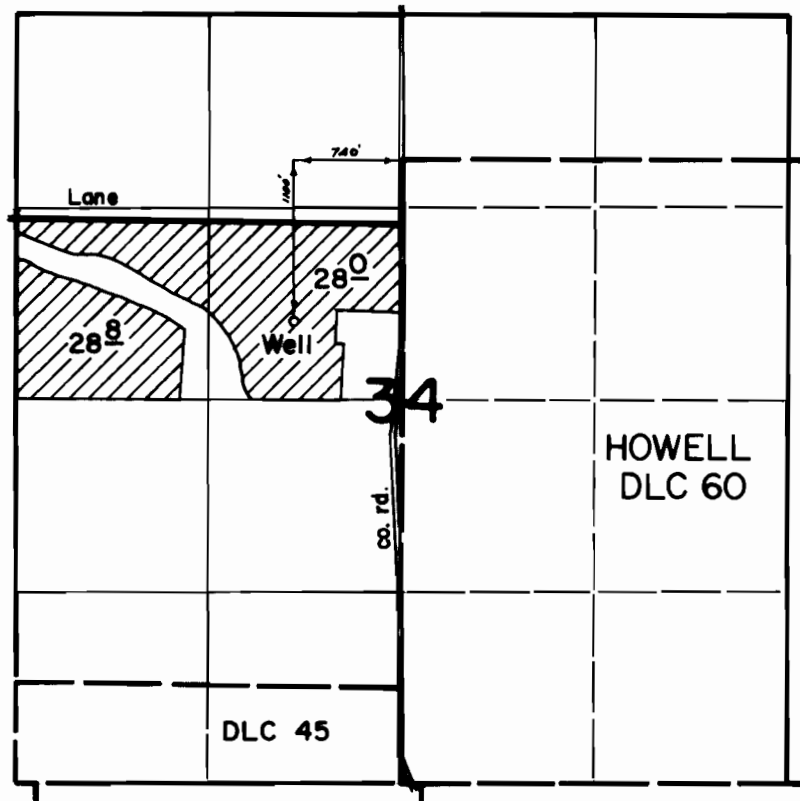

**FINAL PROOF SURVEY**  
UNDER

Application No. G-6209 Permit No. G-5274  
IN NAME OF

CHARLES RAY & VICTORIA ZANDER

Surveyed April 2 1976, by D. Norby