


T.13S.,R.1E.,W.M.

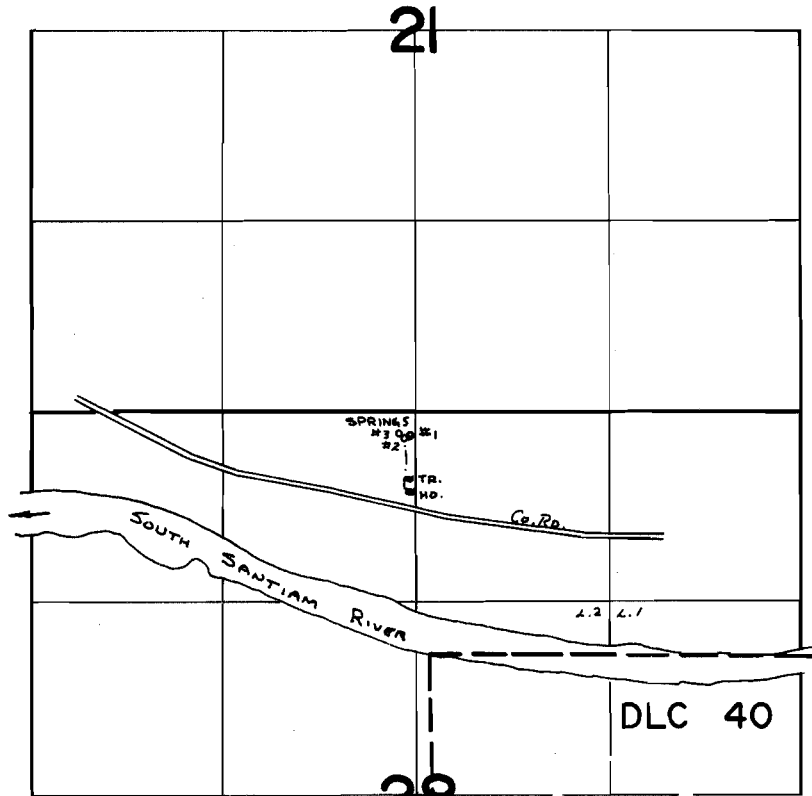

SPRING LOC: #1-160' S AND 50' W }
#2-180' S AND 80' W } ALL FROM N¹/₄ COR. SEC. 28
#3-140' S AND 120' W }

FINAL PROOF SURVEY UNDER

Application No. 48526 Permit No. 36409
IN NAME OF

DAVID D. ROTH

Surveyed JUNE 30 1975, by L. Tall