


T.9S., R.1W., W.M.

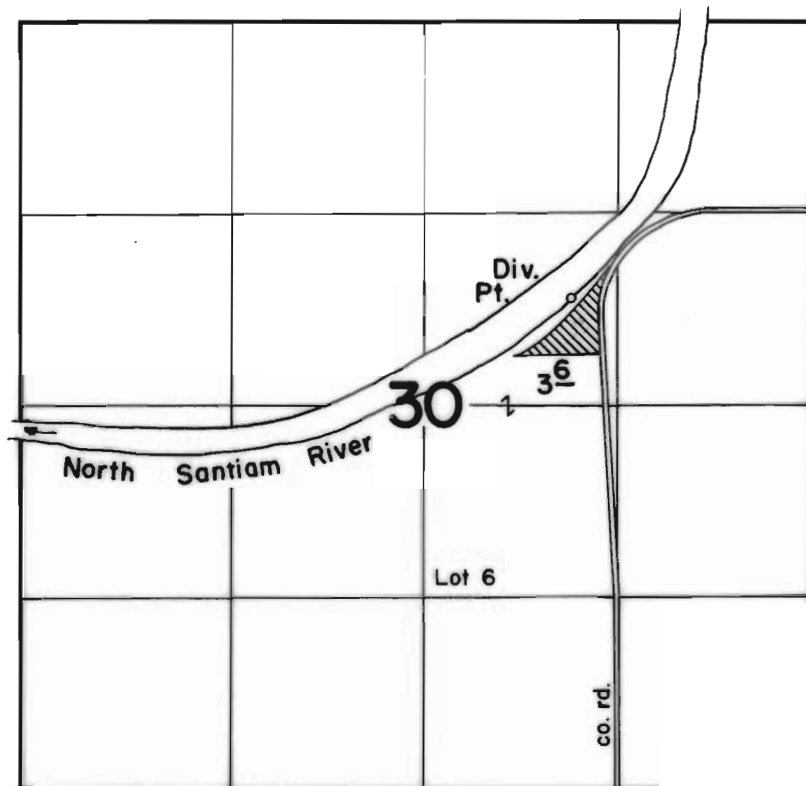

DIV. PT. LOC: 2060' N & 310' W from SE cor. Lot 6

FINAL PROOF SURVEY
UNDER

Application No. 52749 Permit No. 39715
IN NAME OF

LLOYD HOLM

Surveyed Sept. 10 1976, by D. Norby