
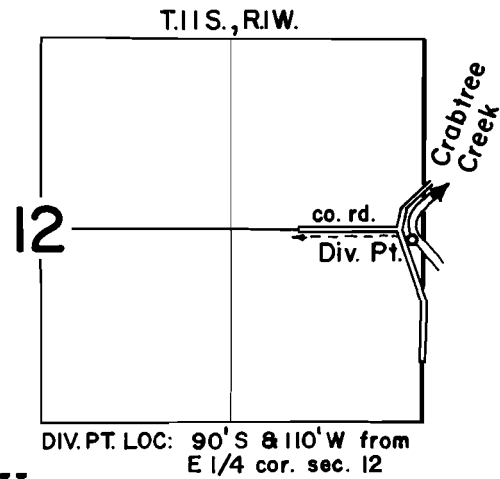


T.10&11S., R.1W., W.M.

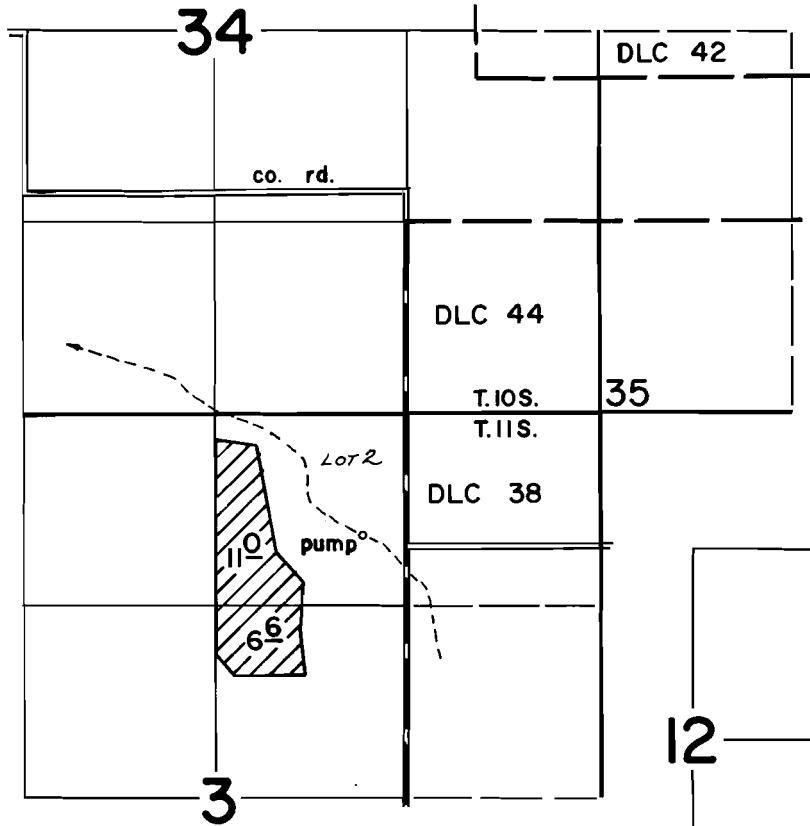

DIV. PT. LOC: 90' S & 110' W from
E 1/4 cor. sec. 12

FINAL PROOF SURVEY UNDER

Application No. 53116 Permit No. 38595
IN NAME OF

HENRY D. UNRAU

Surveyed Sept. 30 1976, by D. Norby