


# T.6S.,R.1W.,W.M.

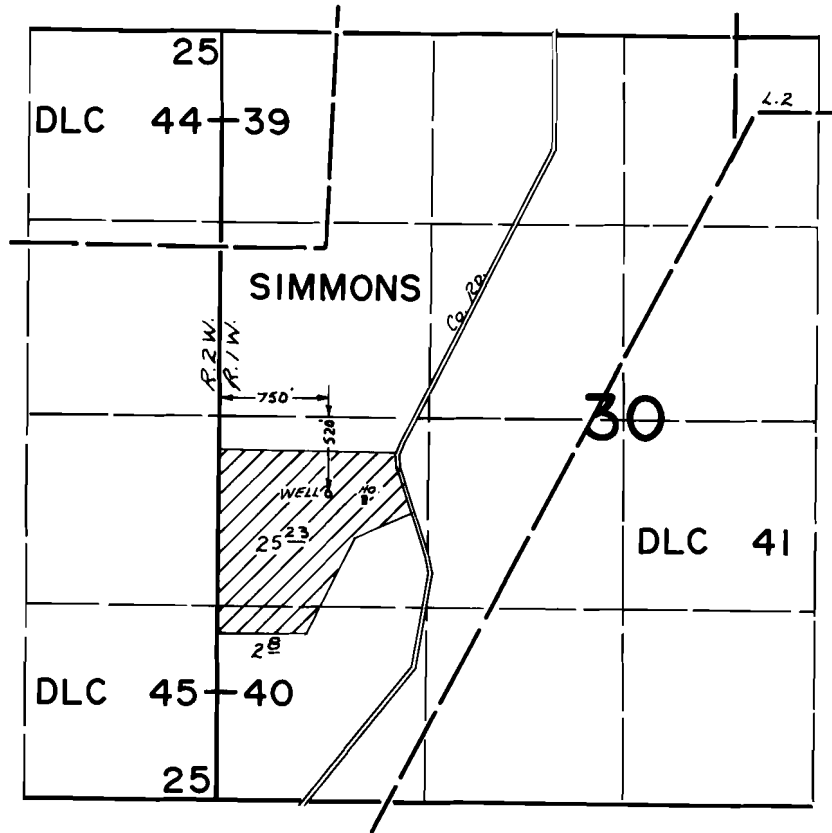

## FINAL PROOF SURVEY UNDER

Application No. G-5263. Permit No. G-5111.  
IN NAME OF

JACK E. LONG

Surveyed Aug. 9, 1976, by L. Toll