


T.7S.,R.IW.,W.M.

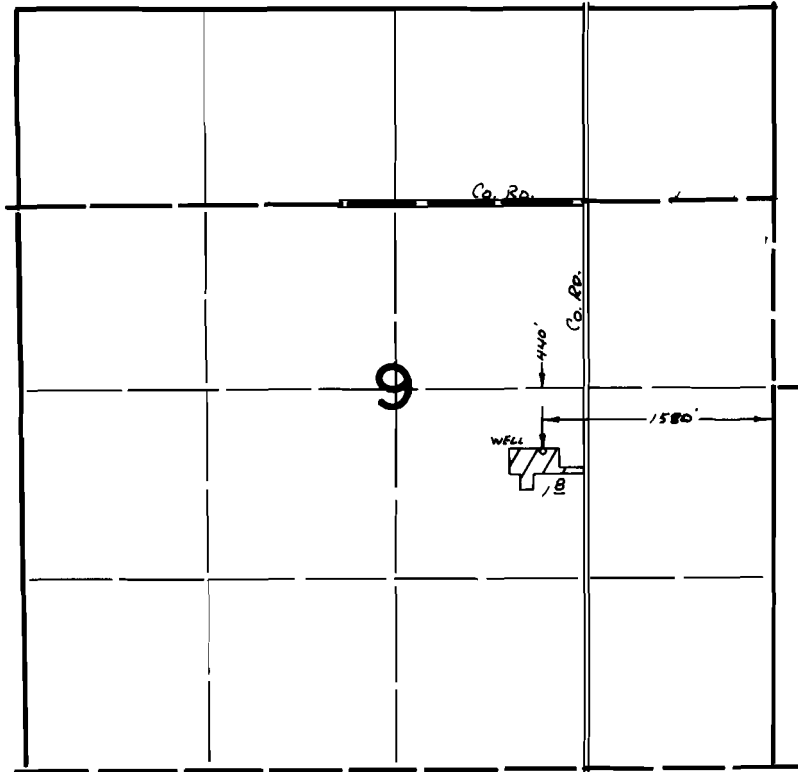

FINAL PROOF SURVEY
UNDER

Application No. G-5296. Permit No. G-5128.
IN NAME OF

CLARENCE BARILEAU

Surveyed Oct. 7, 1976, by L. Tull