


T.7S.,R.2W.,W.M.

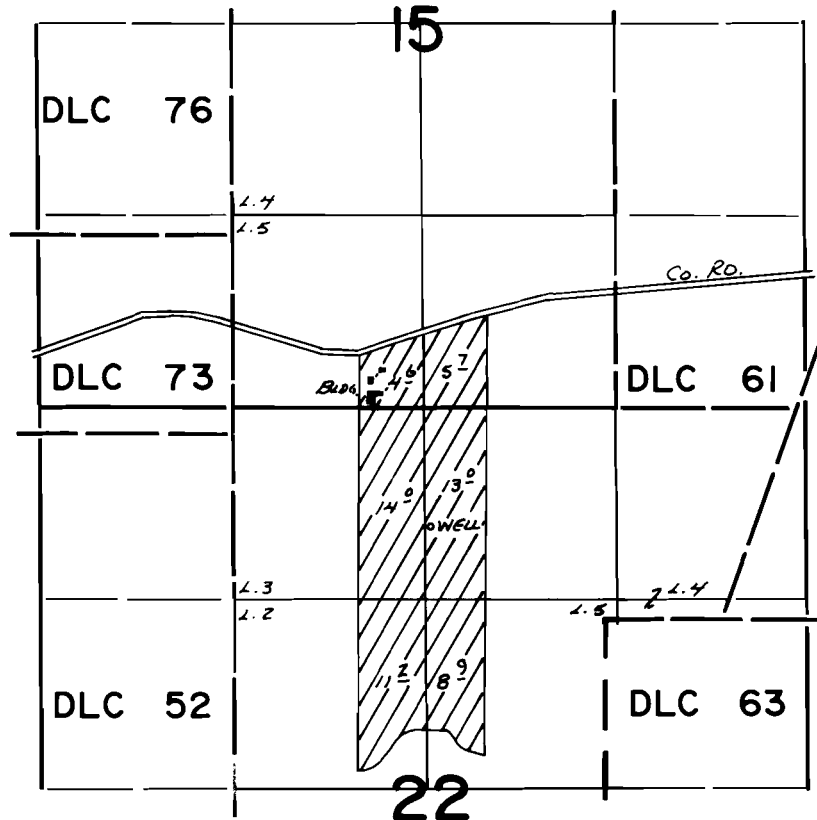

WELL LOC: 810' S AND 40' E FROM N¹/₄ COR. SEC. 22

FINAL PROOF SURVEY
UNDER

Application No. ..G-5403 Permit No. ..G-5340
IN NAME OF

.....PERRY MARVIN DELAPP.....

Surveyed MAY 19 1976, by L. TOLL.....