


T.6S.,R.3W.,W.M.

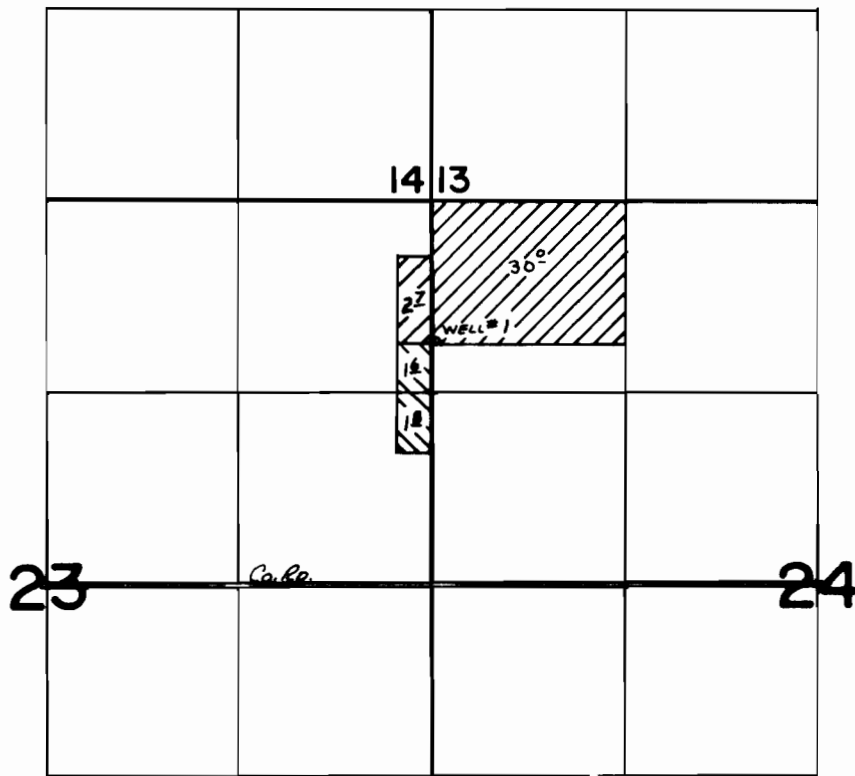

WELL #1 LOC: 1680' N AND 40' E FROM W 1/4 COR SEC. 24



FINAL PROOF SURVEY UNDER

Application No. G-5486. Permit No. G-5390.
IN NAME OF

..... BEACON FARMS, INC.

Surveyed MAY 19 1976., by L. TOLL