T.5S.,R.2W.,W.M.

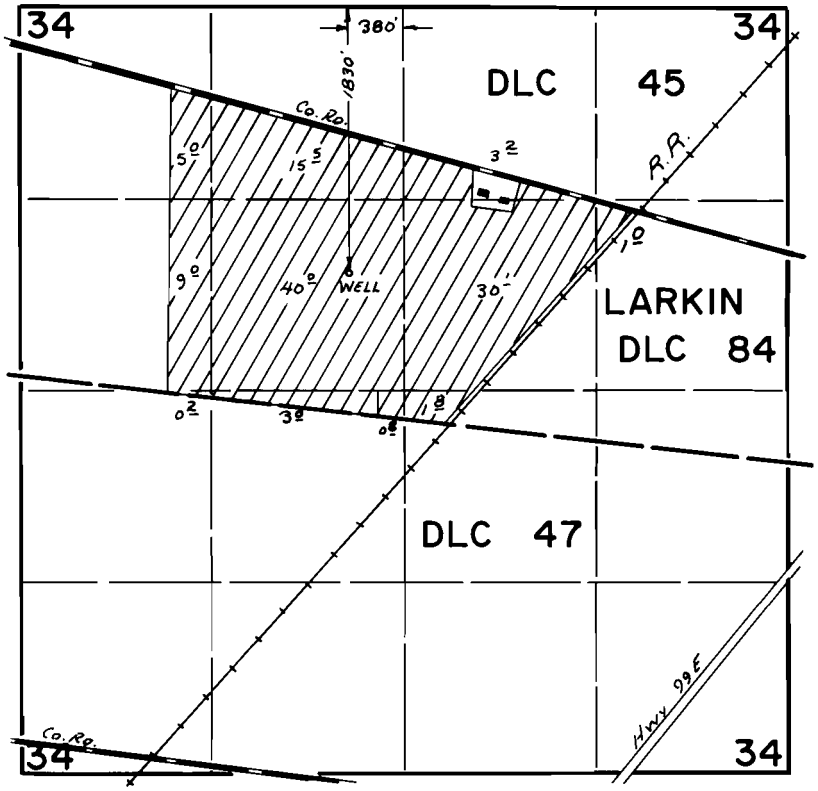

FINAL PROOF SURVEY
UNDER

Application No. G-5595 Permit No. G-5449
IN NAME OF

WILLIAM & CLARA ALBRIGHT

Surveyed APRIL 2 19 76, by L. TOLL

DFN-5LL-262