


T.6S.,R.2W.,W.M.

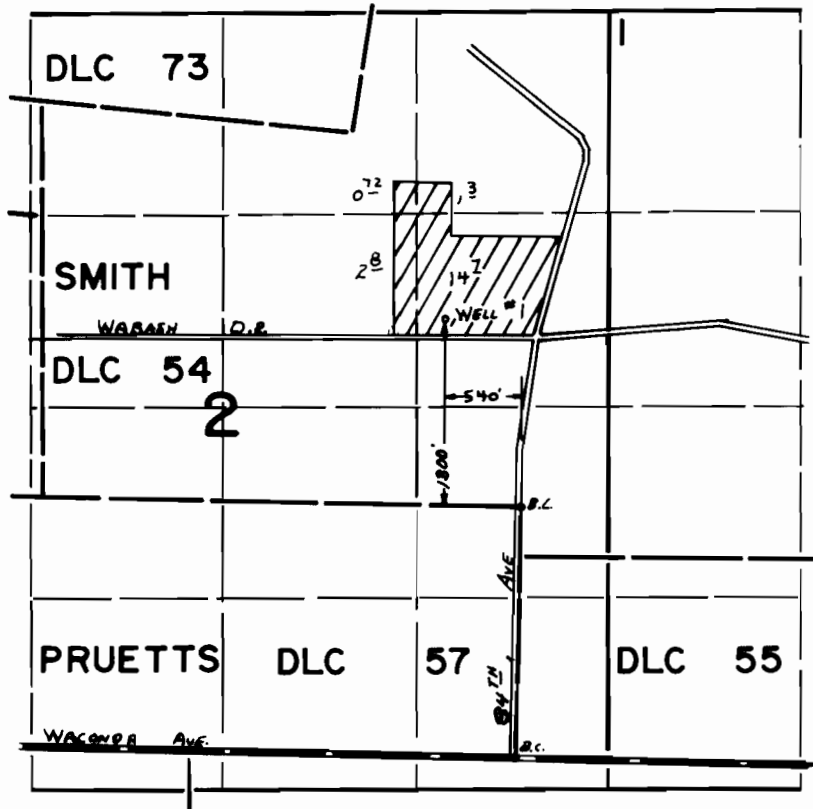

FINAL PROOF SURVEY
UNDER

Application No. G-5796 Permit No. G-5561
IN NAME OF

GRIGORY S. & MARIA SNEGIREFF

Surveyed JUNE 3 1976, by L. TOLL