


T.9S.,R.2W.,W.M.

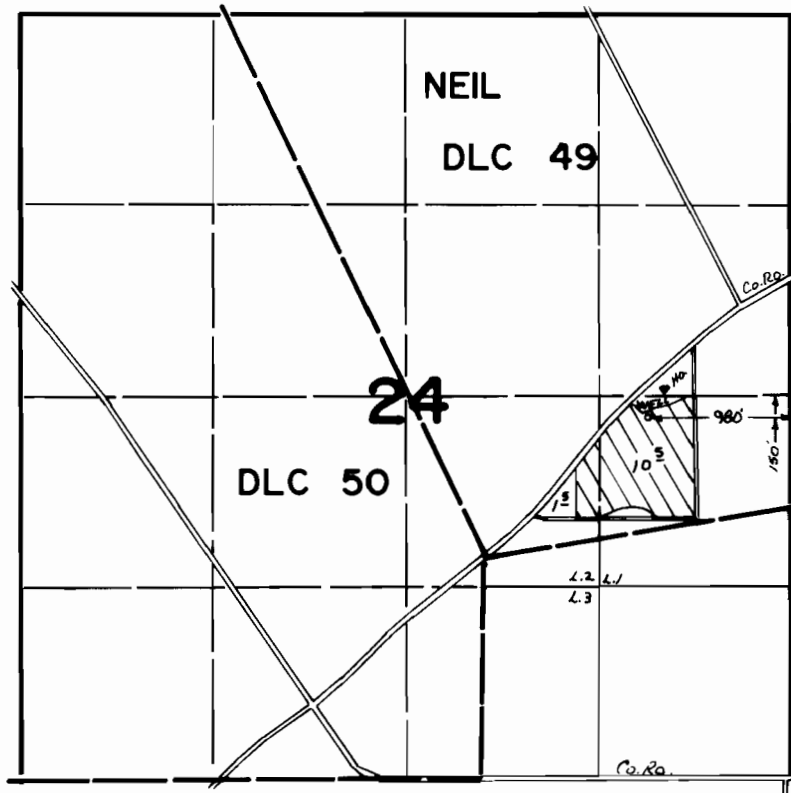

**FINAL PROOF SURVEY**  
UNDER

Application No. G-5847. Permit No. G-5589.  
IN NAME OF

LEE D. GLIDEWELL

Surveyed July 7 1976, by L. Tou