


# T.6S.,R.1W.,W.M.

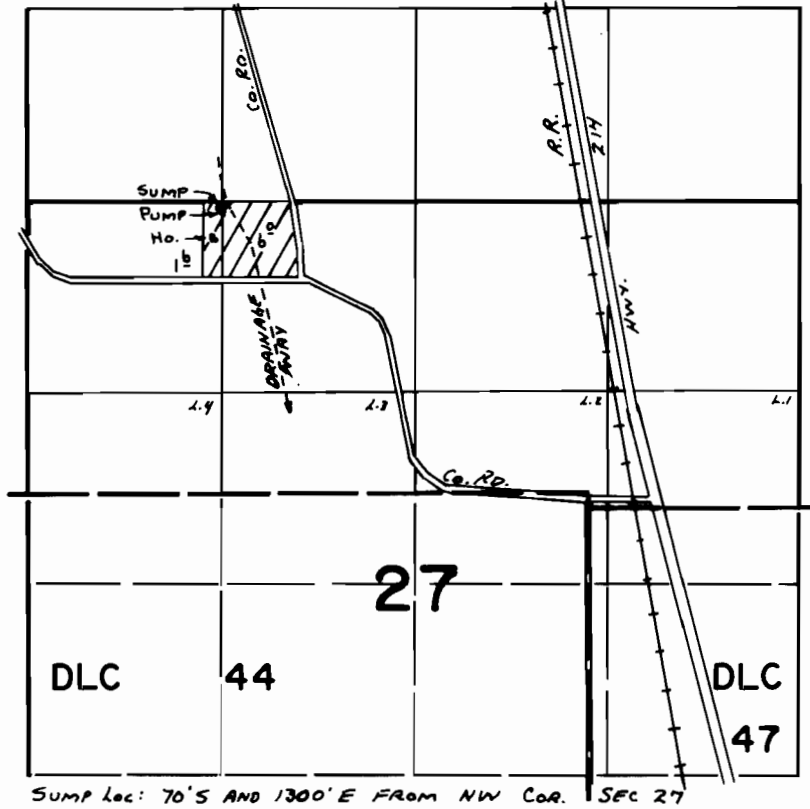

## FINAL PROOF SURVEY UNDER

Application No. ...G-5874. Permit No. ...G-5605.  
IN NAME OF

.....CHARLES M. SMITH.....

Surveyed Aug. 10, 1976., by L. Toll.....