


T.6S.,R.2W.,W.M.

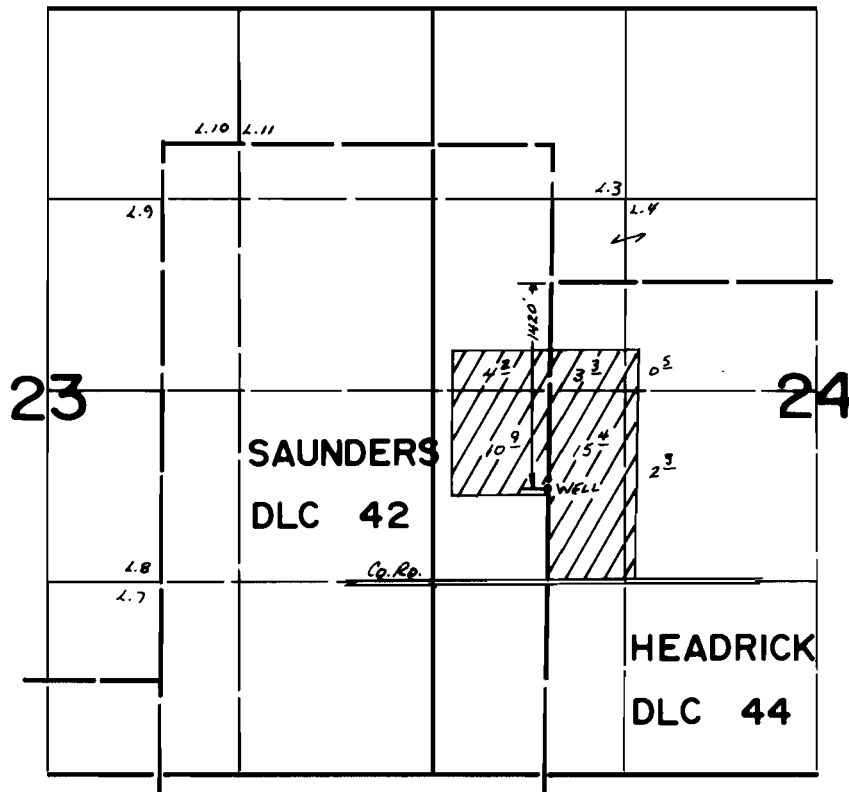

FINAL PROOF SURVEY UNDER

Application No. ..G-5907. Permit No. ..G-5619..
IN NAME OF

.....JOE J. DITCHEN.....

Surveyed JUNE 2... 1976, by L. Toll.....