


T.6S.,R.2W.,W.M.

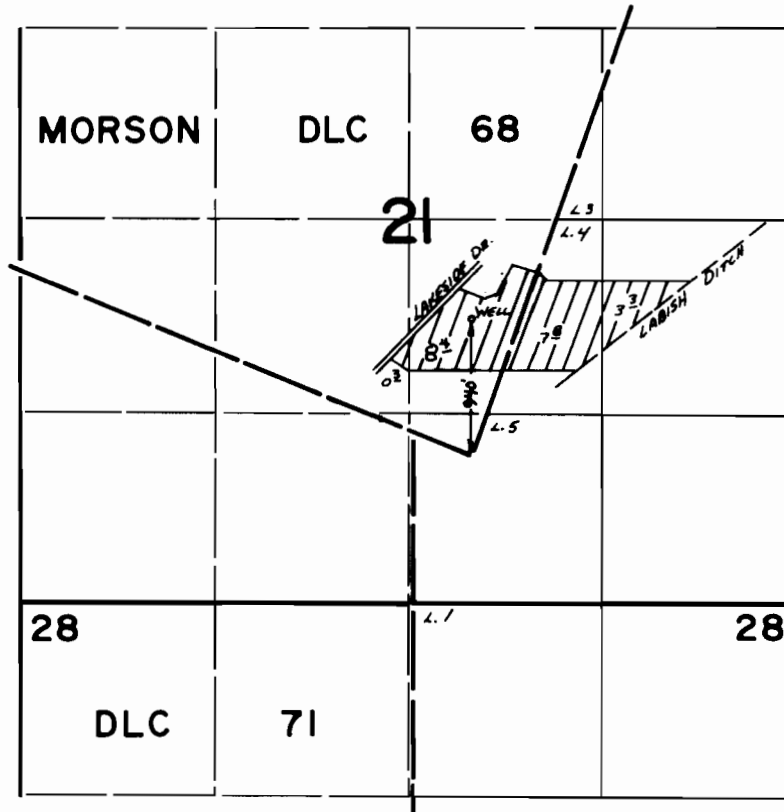

FINAL PROOF SURVEY UNDER

Application No. G-6018.. Permit No. G-5712..
IN NAME OF

..... A. J. HARRIS

Surveyed JUNE 4, 1976, by L. TOW