


T.6S.,R.1W.,W.M.

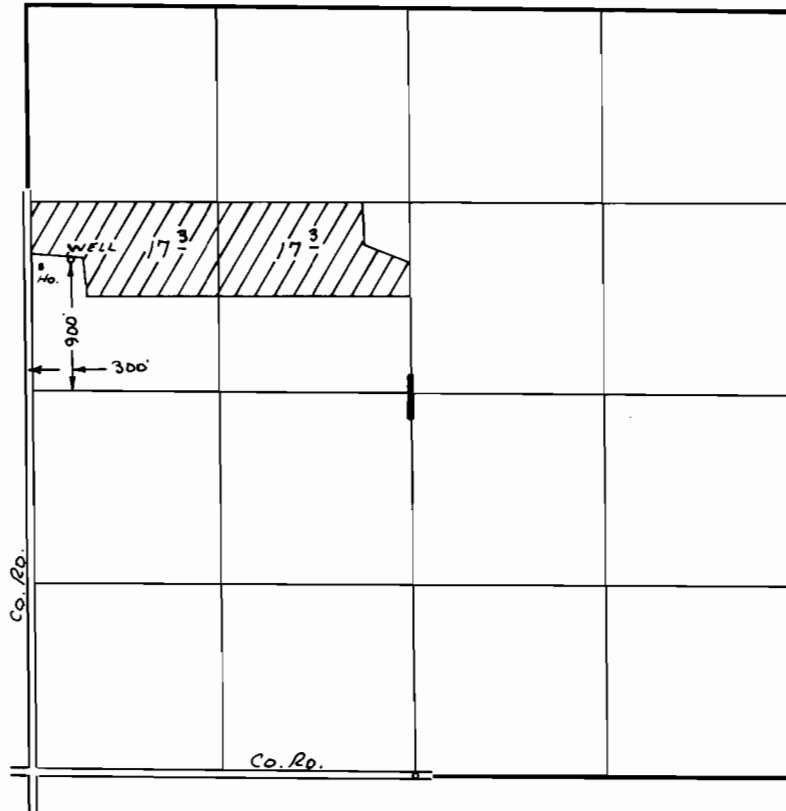

FINAL PROOF SURVEY UNDER

Application No. G-6491. Permit No. G-6109.
IN NAME OF

FRANCIS J. HAMMELMAN

Surveyed Aug. 2, 1976, by L. T. Galt