


# T.6S.,R.2W.,W.M.

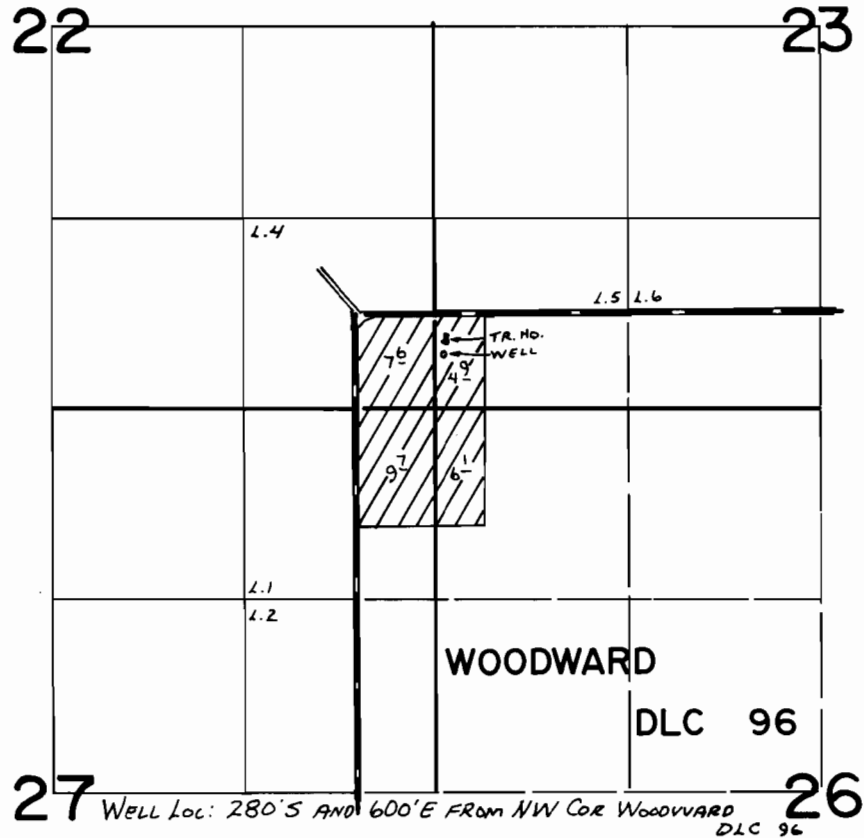

## FINAL PROOF SURVEY UNDER

Application No. ..G-6508. Permit No. ..G-6121...  
IN NAME OF

.....GEORGE MALLORIE.....

Surveyed *MAY 7* 1976, by *L. Toll*.....