


T.7S.R.1&2W.W.M.

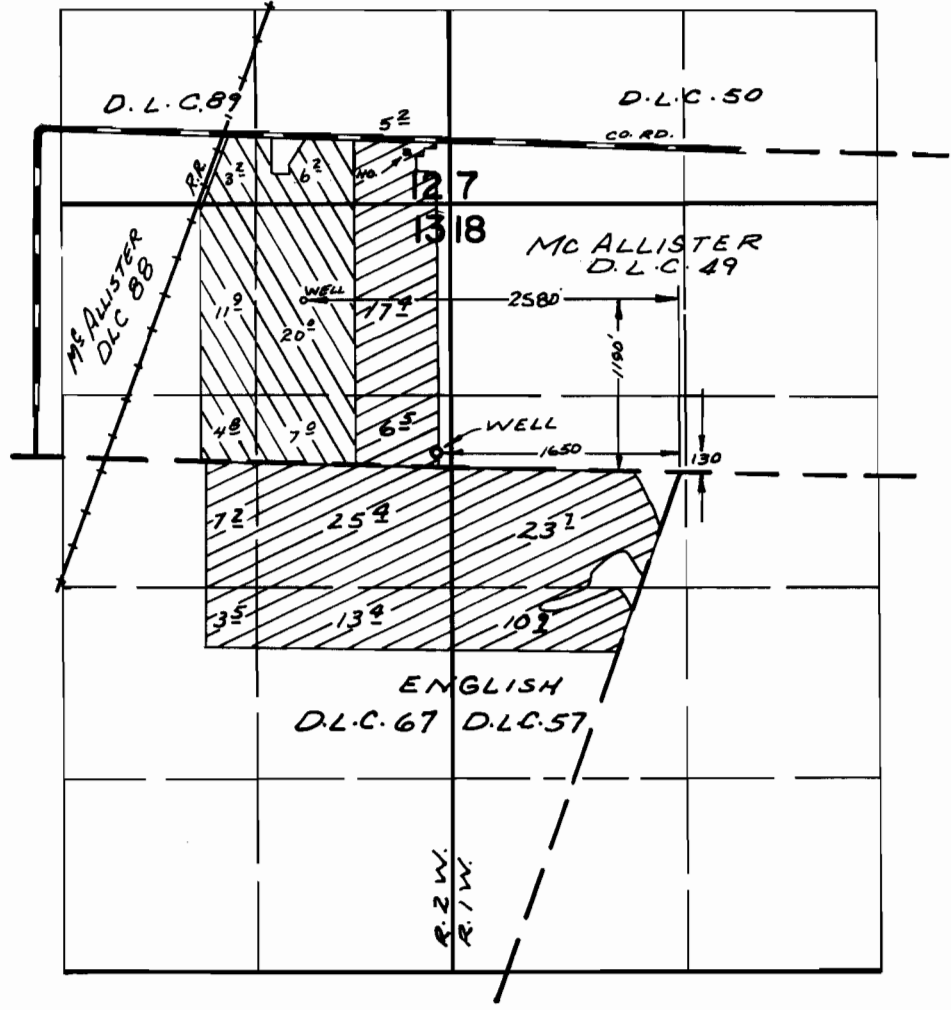

FINAL PROOF SURVEY UNDER

Application No. G-2744 Permit No. G-2771 
IN NAME OF

.....HARLAN E. SCHURTER.....

Surveyed JUNE 2, 1972, by R. MUCKEN
MAY 21, 1976 L. TOLL