


T.5S.,R.2W.,W.M.

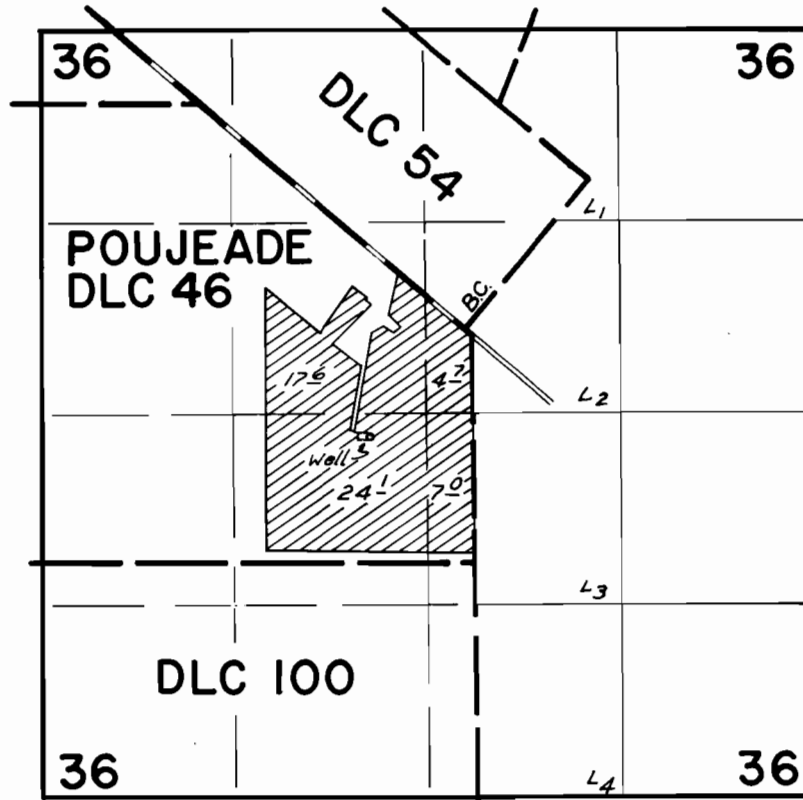

Well Loc.: 730's. & 650'W. from SE Cor. DLC 54

FINAL PROOF SURVEY UNDER

Application No. G-7075 Permit No. G-6549
IN NAME OF

William Van Smoorenburg

Surveyed Aug 11, 1977 by B. Barwin