


T.6S.,R.1E.,W.M.

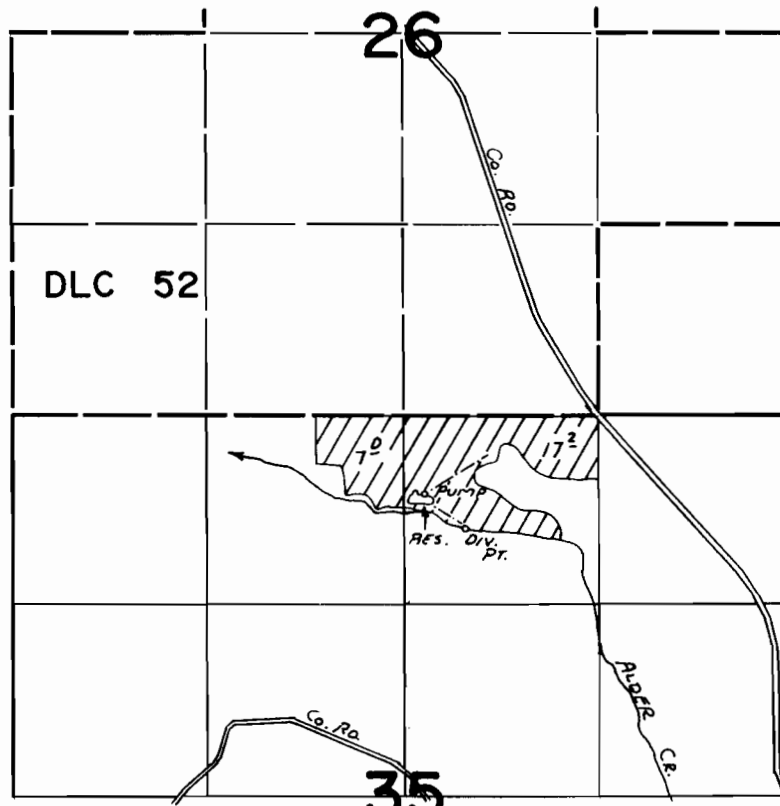

ALDER CR. DIV: 780'S AND 920' W } BOTH FROM NE COR NW 1/4 NE 1/4
DAM LOC: 580'S AND 1300' W } OF SEC 35

FINAL PROOF SURVEY UNDER

R-47372 R-5703
Application No. 47373 Permit No. 35480
IN NAME OF

T. R. HAZEL

Surveyed Aug. 12, 1976, by L. Toll