


T.6S.,R.1E.,W.M.

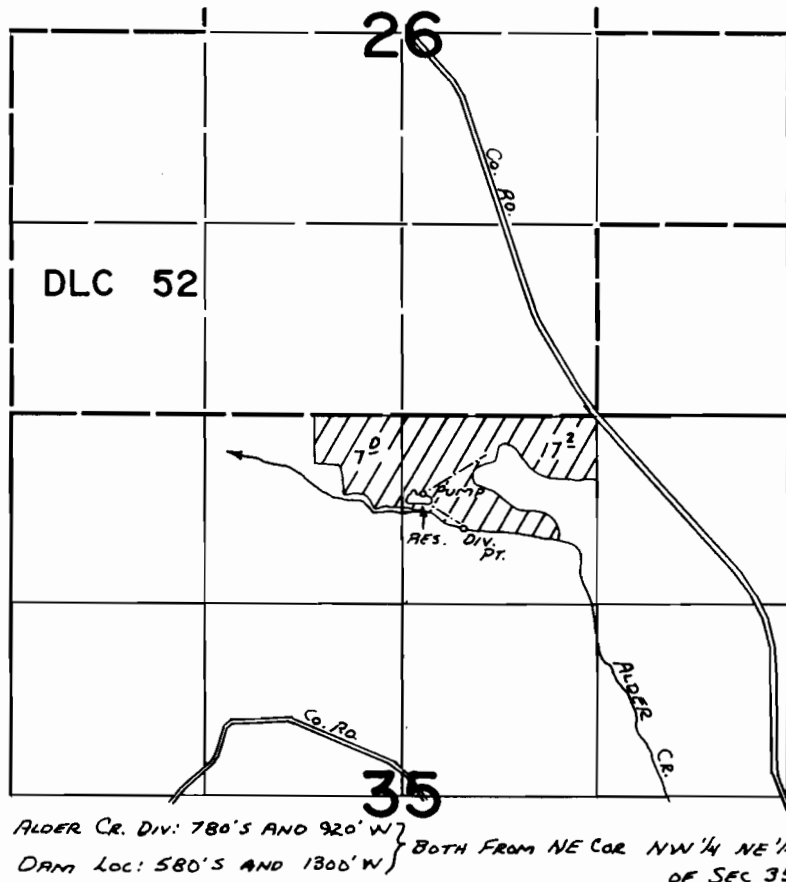

FINAL PROOF SURVEY
UNDER

R-47372 R-5703
Application No. 47373 Permit No. 35480
IN NAME OF

T. R. HAZEL

Surveyed Aug. 12, 1976, by L. Toll