


T.7S.,R.1W.,W.M.

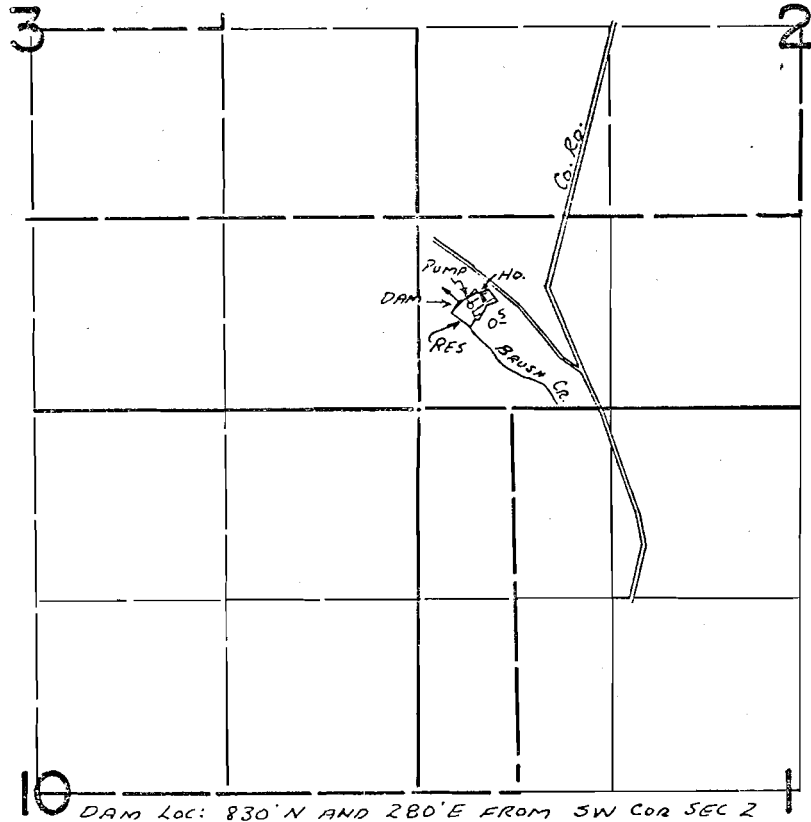

**FINAL PROOF SURVEY**  
UNDER

R-48742                      R-5802  
Application No. 48743 Permit No. 35926  
IN NAME OF

ROBERT YANDELL

Surveyed Oct. 7 1976, by L. Toll