


T.6S.,R.1W.,W.M.

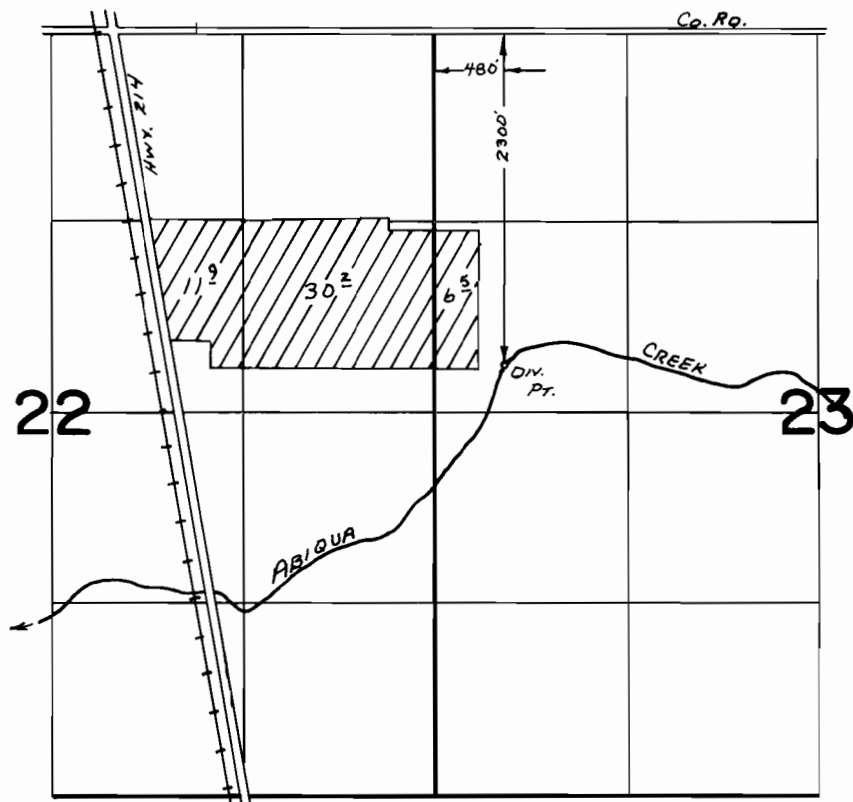

FINAL PROOF SURVEY UNDER

Application No. 52307... Permit No. 37531...
IN NAME OF

CLYDE E. REED

Surveyed Aug. 10. 1976., by L. Telle