


T. 8 S. R. 1 W. W. M.

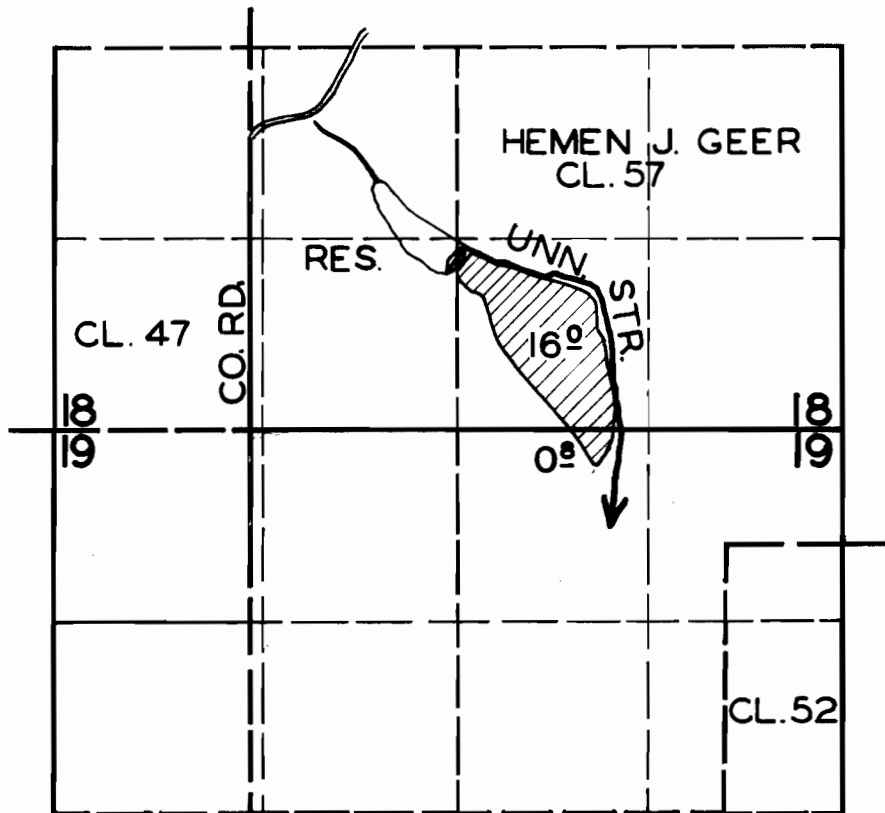

FINAL PROOF SURVEY

UNDER

R-23686

R-1085

Application No. 23687 Permit No. 1991

IN NAME OF

FORREST C. TURNER

Surveyed 5 MAR 1956, by M. BISH