


T.6S. R.6W.W.M.

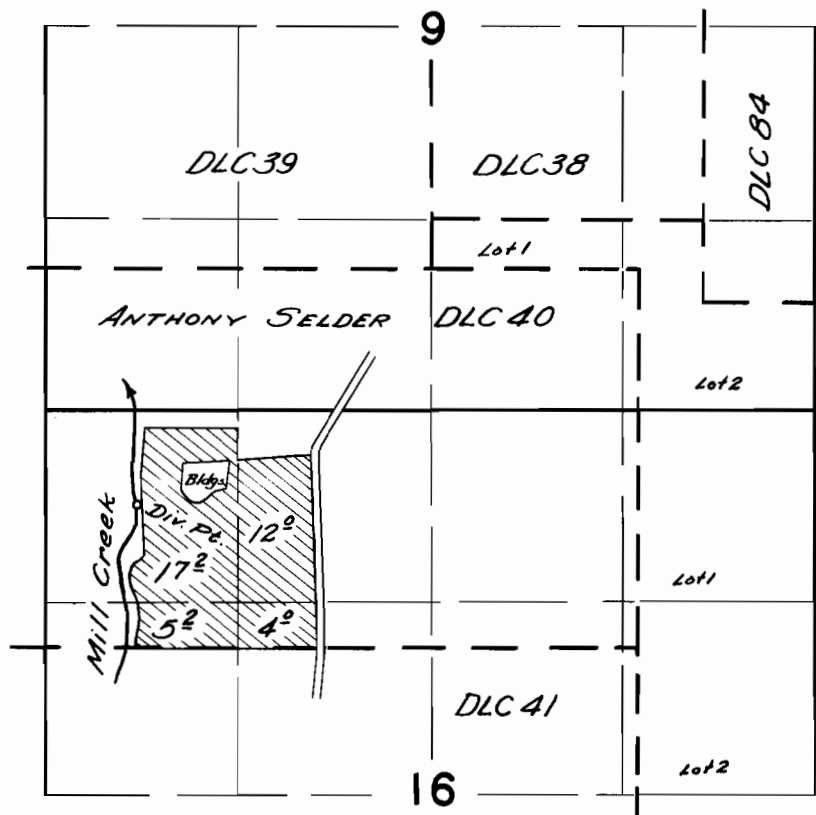

**FINAL PROOF SURVEY**  
UNDER

Application No. 31301 Permit No. 24652  
IN NAME OF

Toivo J. Simonson

Surveyed June 22, 1960, by C.O. Bartsch