


P-35878  
42773

# T.1N.R.19E.W.M.

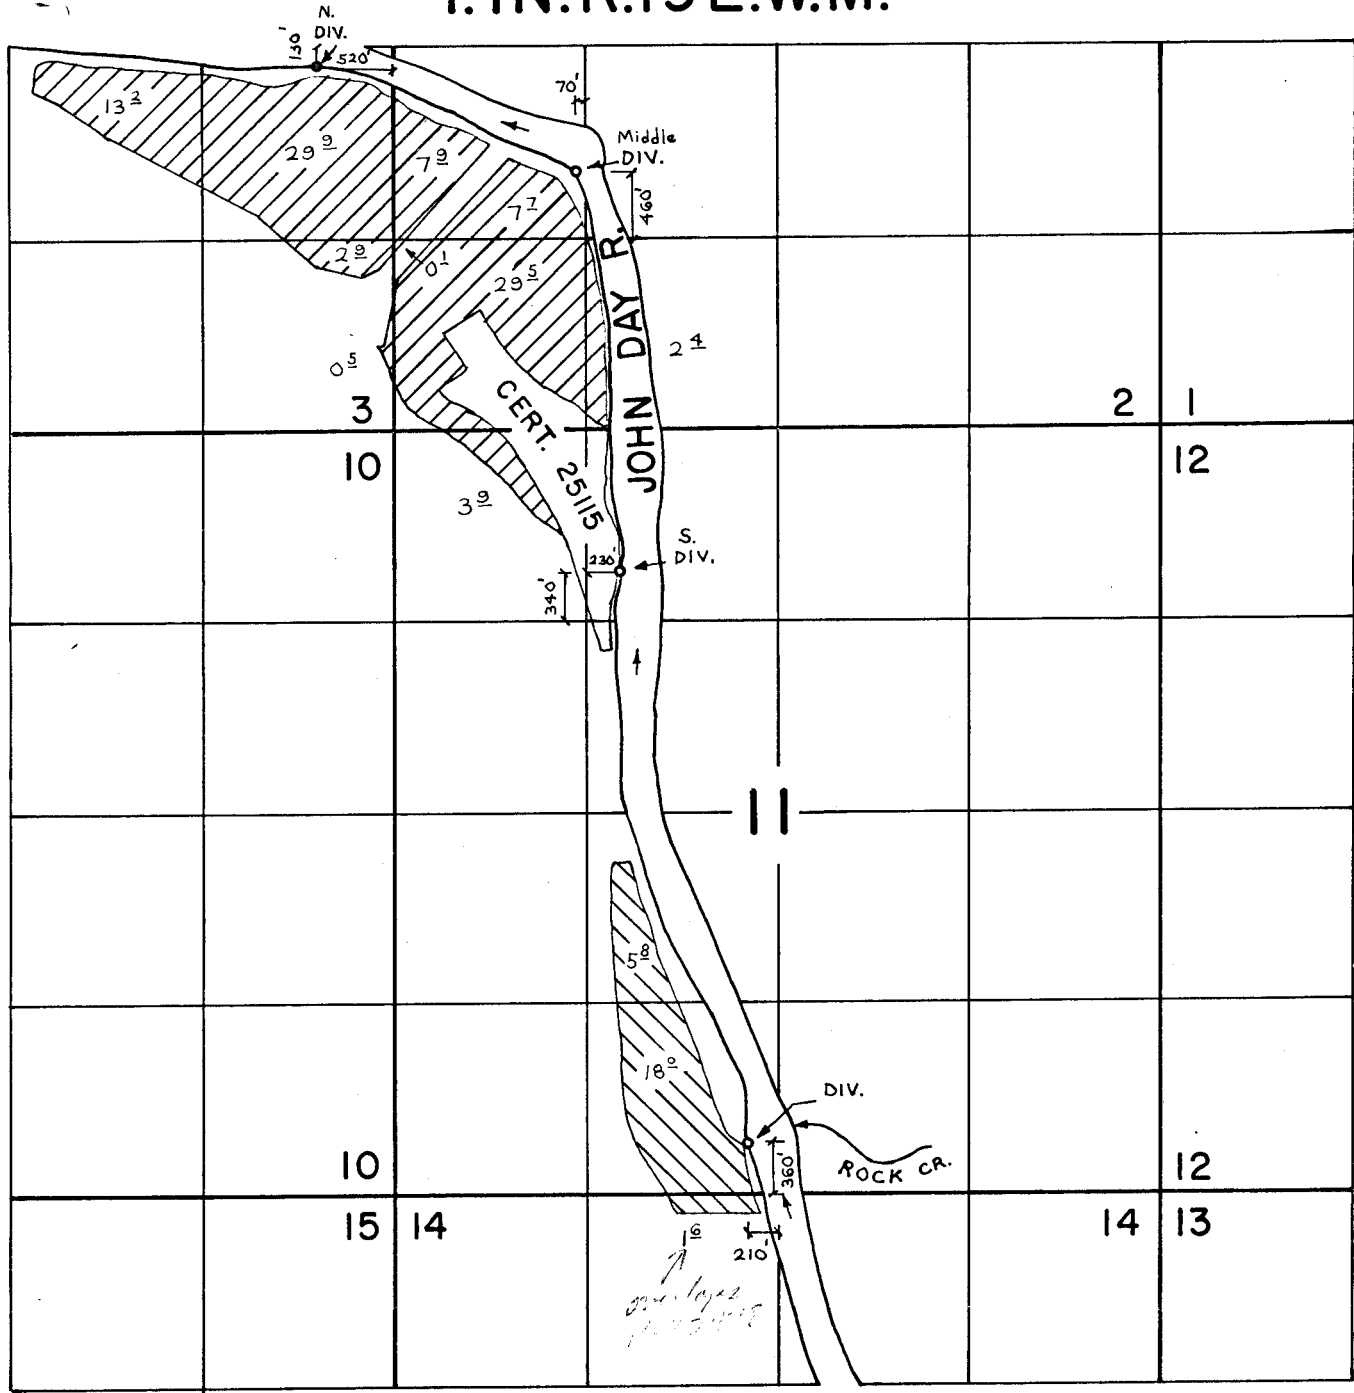

## FINAL PROOF SURVEY UNDER

Application No. 47876 Permit No. 35877   
 Application No. 47877 Permit No. 35878 

IN NAME OF  
**BIG SKY RANCH INCORPORATED**

Surveyed July 13, 1976, by R.G. Mucken.

DHM  
272-195  
1976 Z-1