


# T. 4 S. R. 9 & 10 W. W. M.

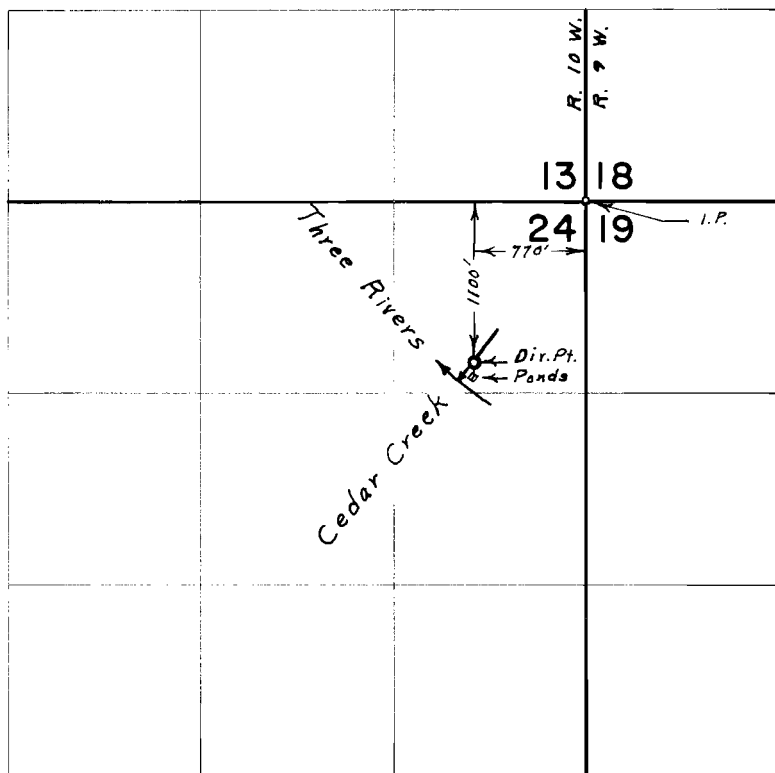

## FINAL PROOF SURVEY UNDER

Application No. 45975 Permit No. 34342  
IN NAME OF

OREGON STATE GAME COMMISSION

Surveyed Aug. 9, 1971, by L. E. Gould