


G 5518
46730

T. 4N. R. 35E. W.M.

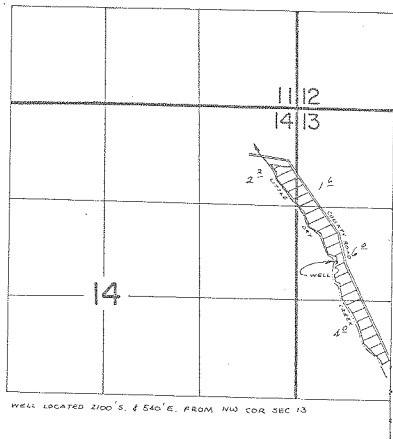

FINAL PROOF SURVEY
UNDER

Application No. G.5713... Permit No. G.5518...
IN NAME OF

.....CLIFFORD PRICE.....

Surveyed NOV. 11, 1977, by R. BARWIN.....