T.IN.,R.32E.,W.M.

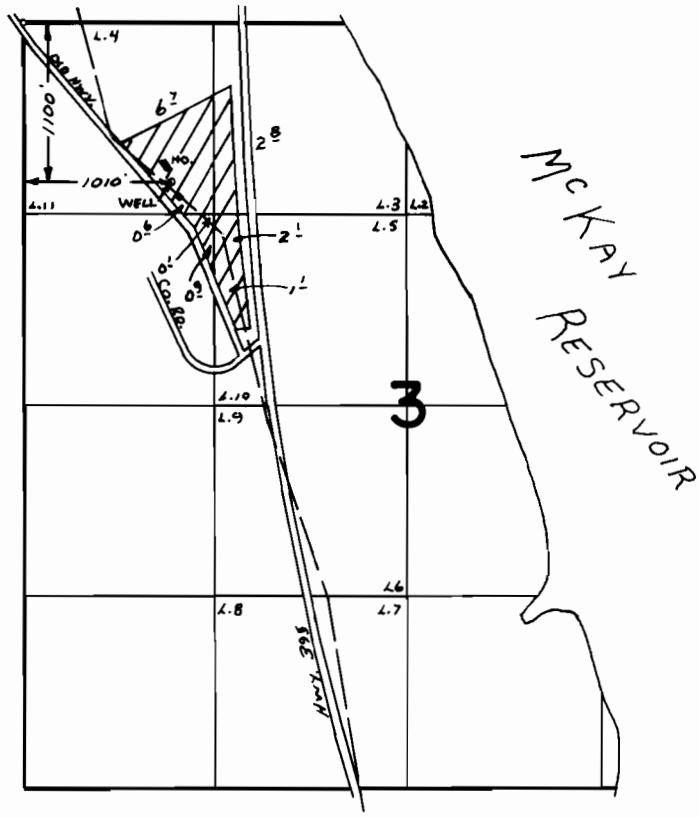

FINAL PROOF SURVEY
UNDER

Application No. G-6195 Permit No. G-5865
IN NAME OF

BRUCE A. MALCOM

Surveyed April 8 1976, by L. Toth

PTS 1976-4