


T.3S.,R.38E.,W.M.

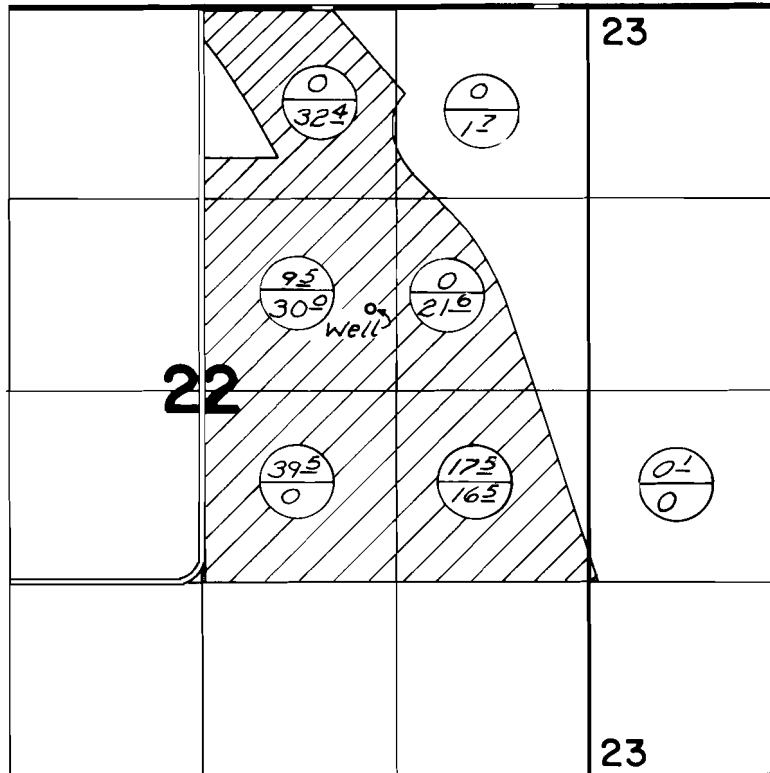

Well Loc.: 2050'S. & 1480'W. from NE cor. Sec. 22



Primary under Permit - 5323

Supplemental to Certs. - 6441 & 6485

FINAL PROOF SURVEY
UNDER

Application No. G-5398 Permit No. G-5323
IN NAME OF

Art McCall

Surveyed Sept. 22, 1976, by D. M. Norby