


T.2S., R.39E., W.M.

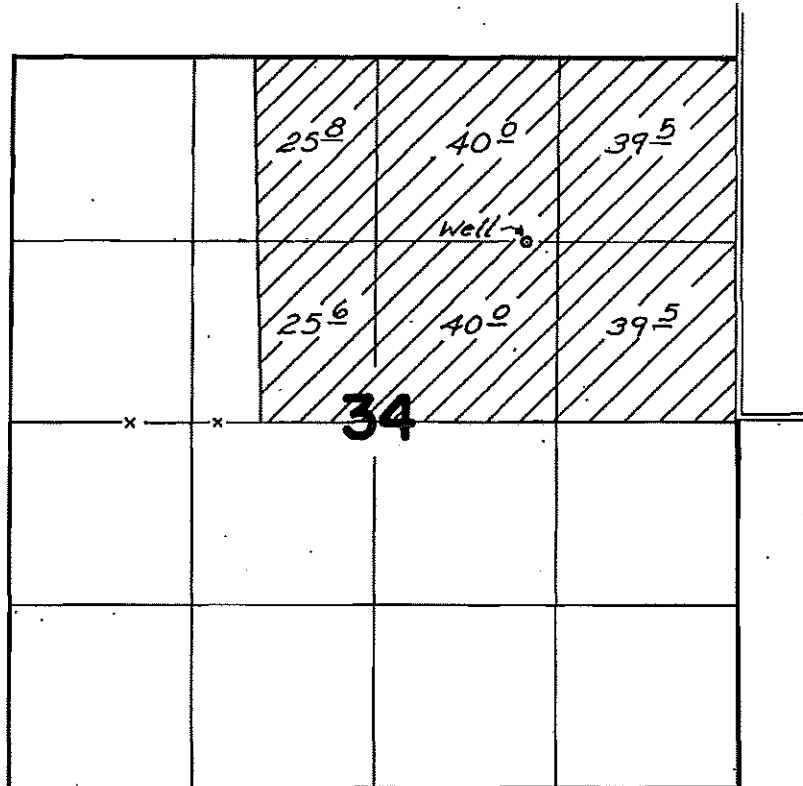

Well Loc.: 1320' S. & 1530' W. from NE Cor. Sec. 34

FINAL PROOF SURVEY
UNDER

Application No. G-5510 Permit No. G-5404
IN NAME OF

Robert E. Gulzow

Surveyed Sept. 27, 1976 by D. M. Norby

AH-2MM-150 *dlb*