


T.2S.,R.39E.,W.M.

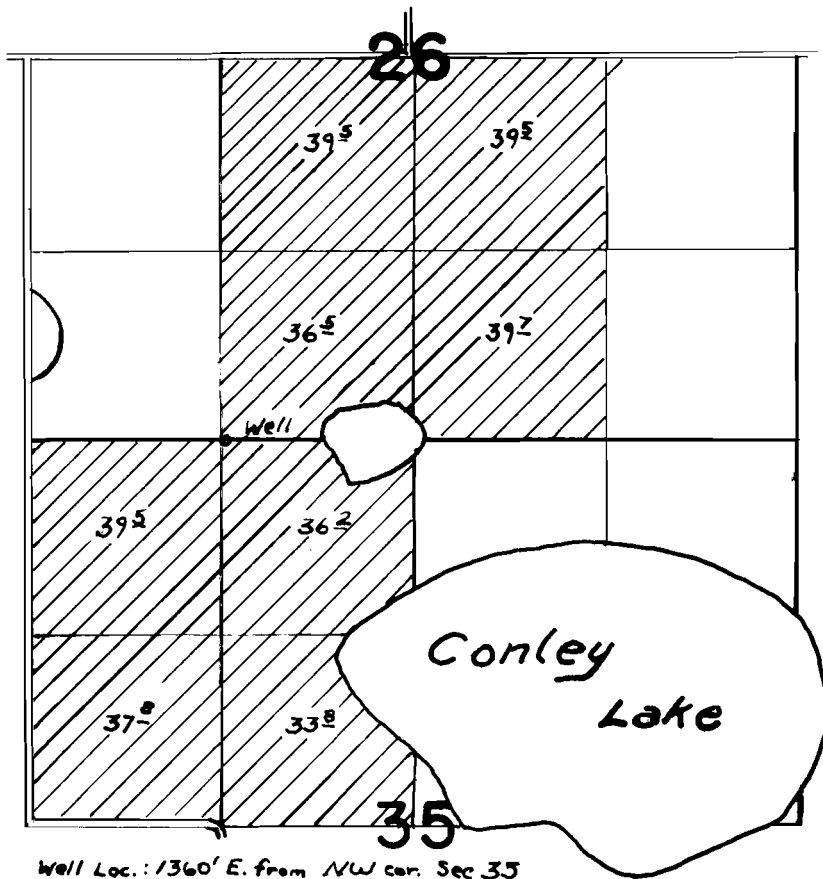

FINAL PROOF SURVEY
UNDER

Application No. G-5650 Permit No. G-5467
IN NAME OF

Carmarco Inc.

Surveyed Sept. 25, 1976, by D. M. Norby