


T.4 S., R.38 E., W.M.

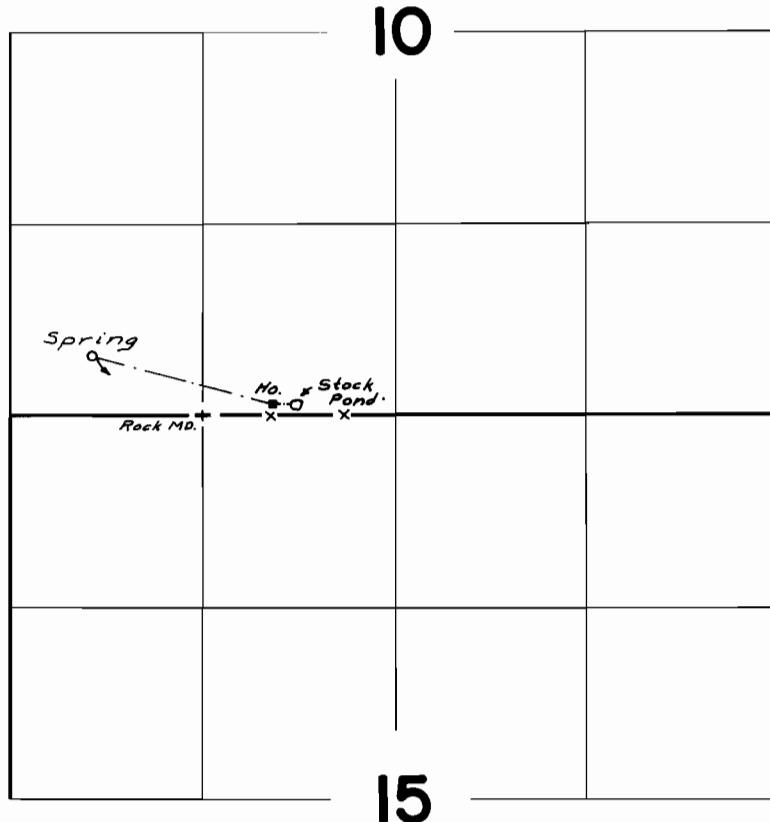

Spring Loc.: 410' N. & 760' W. from SE Cor SW $\frac{1}{4}$ SW $\frac{1}{4}$
Sec. 10

FINAL PROOF SURVEY
UNDER

Application No. 51358 Permit No. 38840
IN NAME OF

Eldon L. Waite

Surveyed Sept 28, 1976, by D. M. Norby