


RECEIVED

NOV 27 1974

STATE ENGINEER
SALEM, OREGON

T.2S. R.39E. W.M.

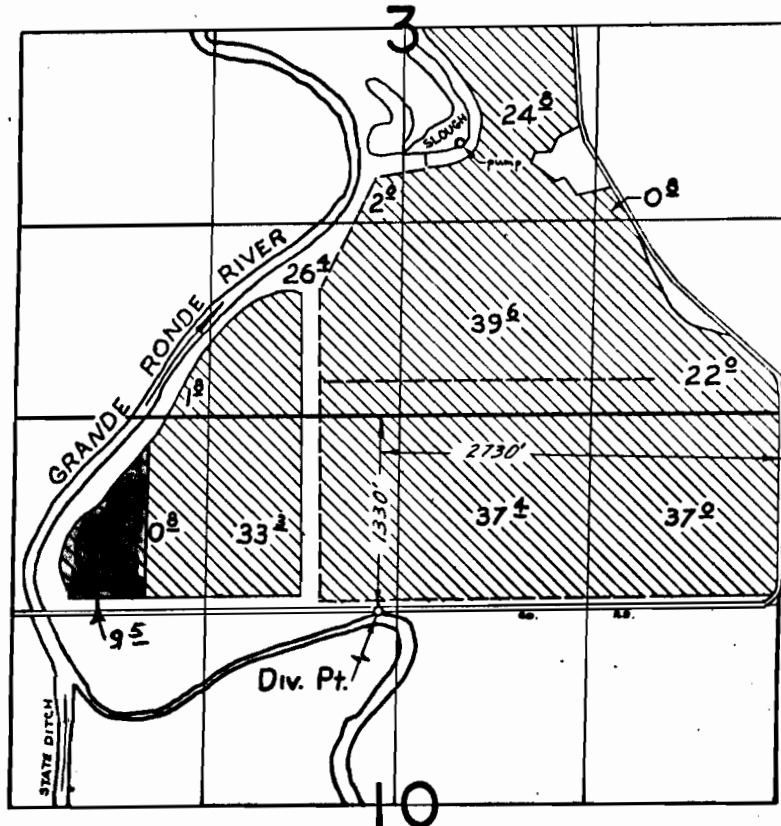

 = New land

FINAL PROOF SURVEY
UNDER

Application No. 42002 Permit No. 31433
IN NAME OF

LOREN & MARY FLEET

Surveyed JULY 18, 1973, by R.G. MUCKEN

Application No. 52607
Permit No. 39667