


T. 5 & 6 S. R. 6 W. W.M.

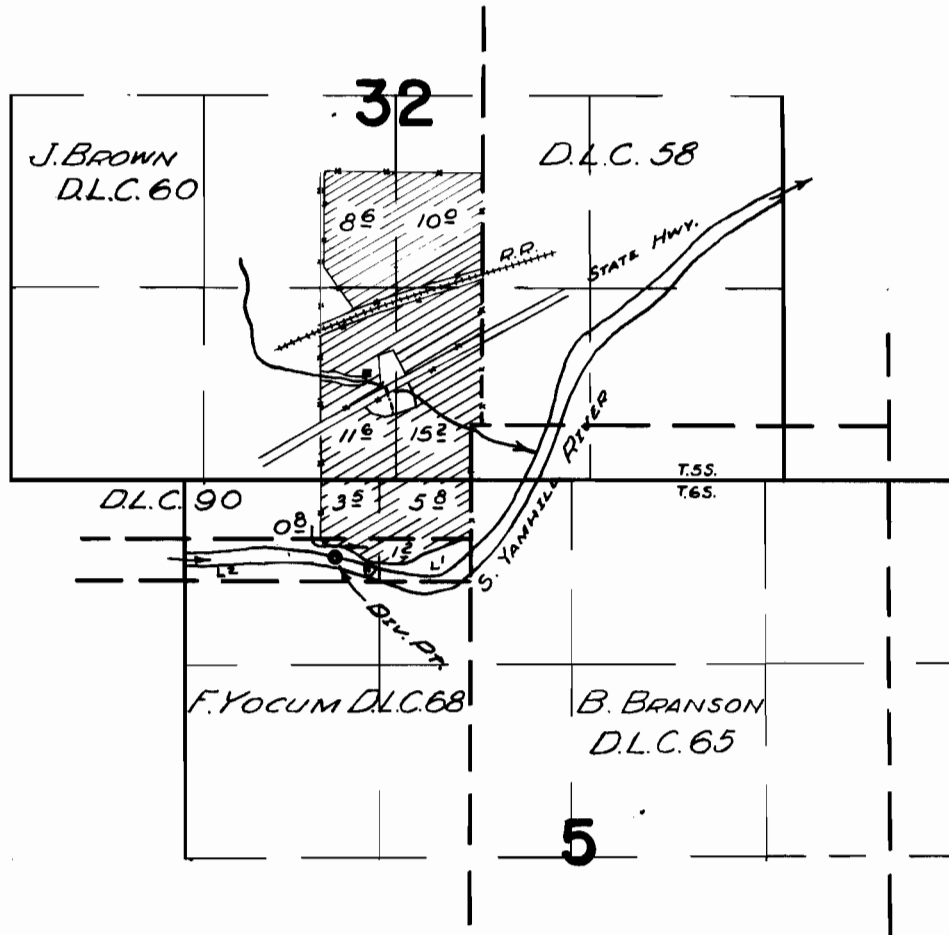

FINAL PROOF SURVEY UNDER

Application No. 31387 Permit No. 24706
IN NAME OF

DAN GARDNER

Surveyed 28 APRIL 1961, by M. B. Bick