


T. 1 N. R. 3 W. W. M.

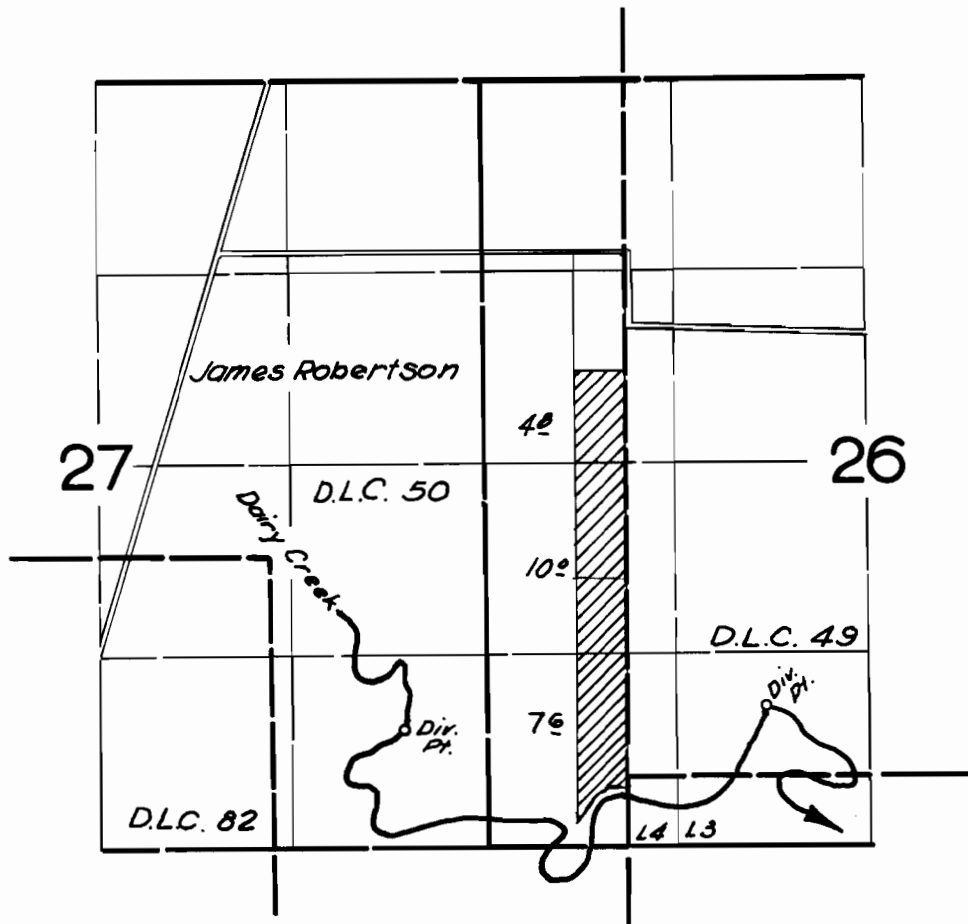

**FINAL PROOF SURVEY**  
UNDER

Application No. 31051 ... Permit No. 24399.  
IN NAME OF

*CECIL N. KINDEL*

Surveyed 26 May 1959, by *R. Jackson*