


T.5S.,R.6W.,W.M.

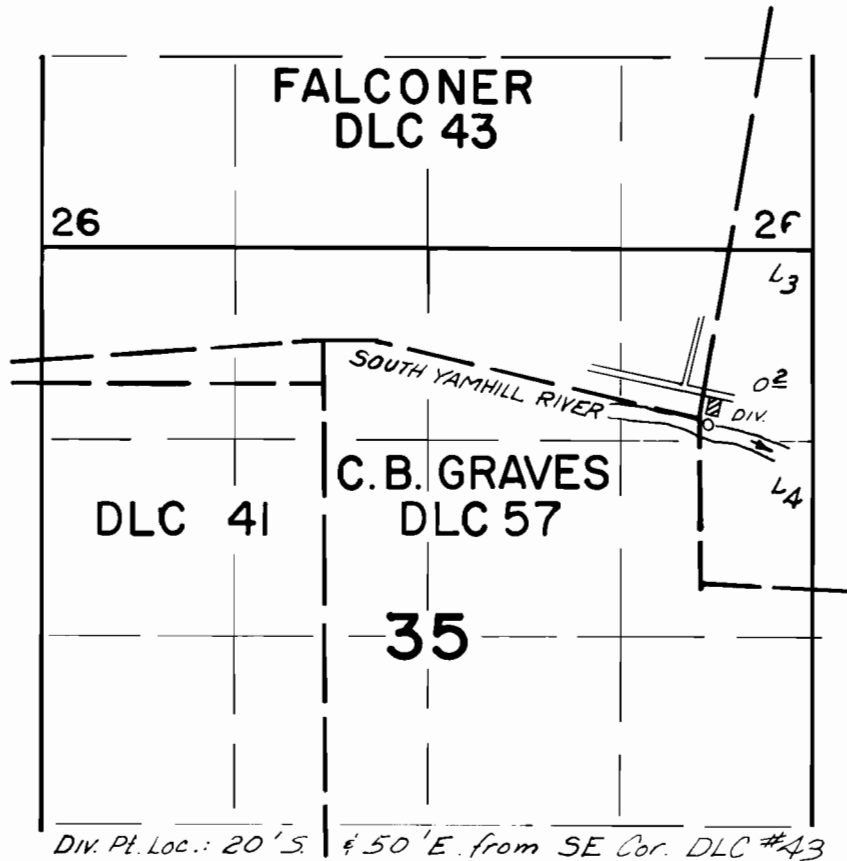

**FINAL PROOF SURVEY**  
UNDER

Application No. 52946 Permit No. 39973  
IN NAME OF

FAYE HUTCHINS

Surveyed AUG 4, 1976 by D. NORBY

DFG-3LL-149 *CB*